


J. E. TAYLOR

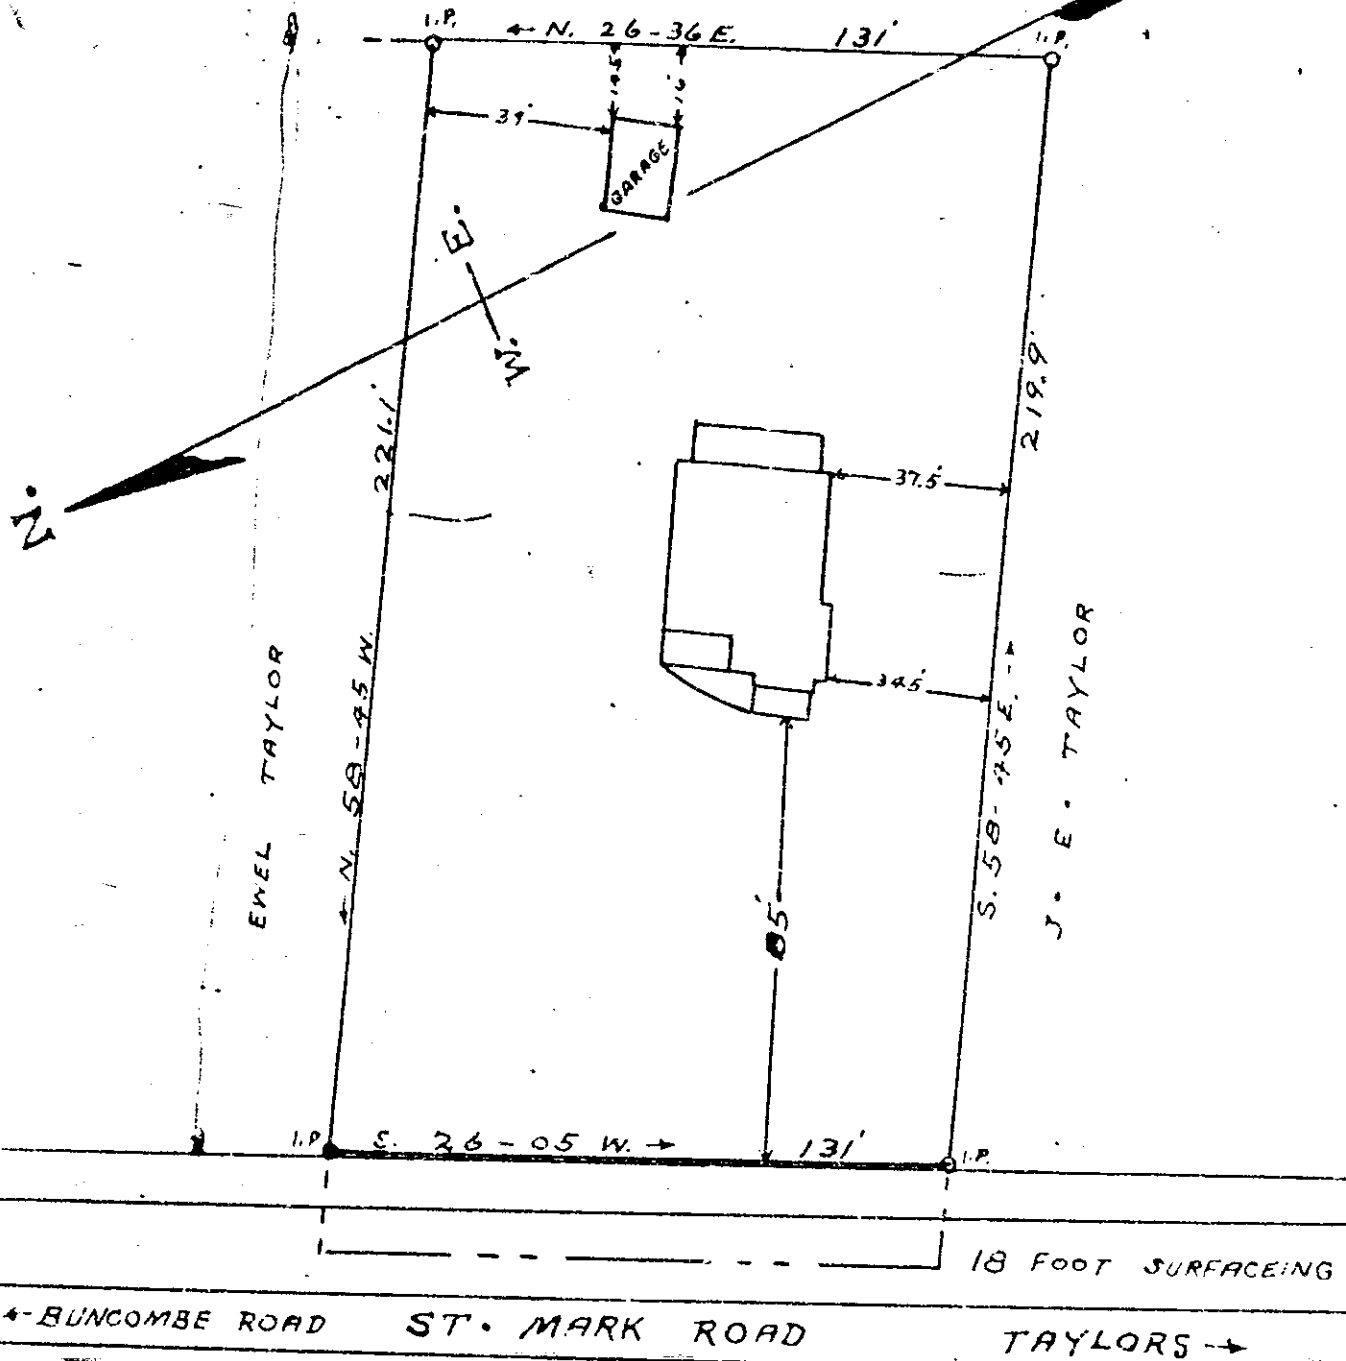

PROPERTY OF

ROBERT J. TURNBULL

LOCATED THREE MILES NORTHWEST FROM GREER, S.C.

CHICK SPRINGS TOWNSHIP GREENVILLE COUNTY

SOUTH CAROLINA

SCALE: 1" = 40 FEET

MAY 23 1951

I hereby certify that on May 23rd 1951 I surveyed the the
 property shown above and that the measurements as shown on
 this plat are correct and that there are ^{no} projections or
 encroachments other than are shown.

Recorded February 20th. 1954 at
 10:00 A. M. #3983

H. S. Brockman
 Registered surveyor in S.C. - No. 359