

FILED 00 S.S.
GREENVILLE S.C.
DEC 28 11 39 AM 1954
GEELEFABNS NORTH
S.M.C.
DEC 28 1954

29590

G. H. WATERS, JR. & E. R. MINUS, JR.

LOCATED THREE MILES NORTH FROM GREER
ONEAL TOWNSHIP GREENVILLE COUNTY

SOUTH CAROLINA

SCALE: 1" = 100 FEET. NOVEMBER 24, 1947.

SURVEYED NOVEMBER 20, 1947.


H. S. BROCKMAN, SURVEYOR.
GREER, S.C.

PROPERTY OF

GEORGE SOUTHERN ESTATE

9.30 ACRES

(6)

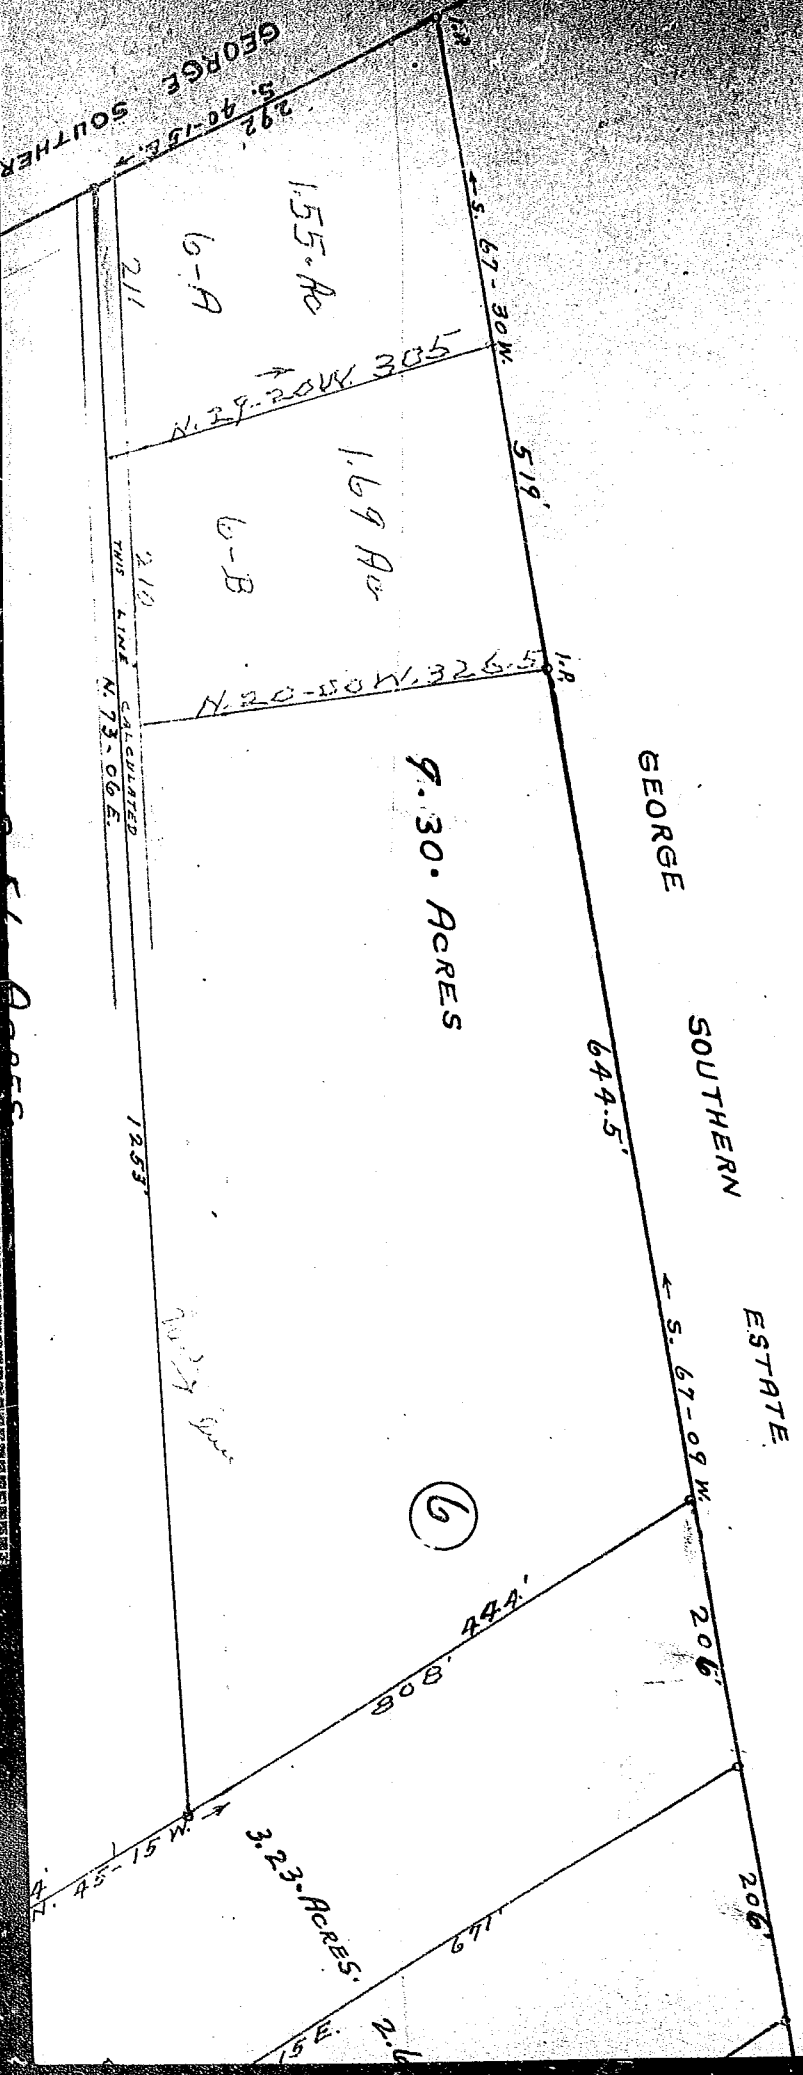

GEORGE SOUTHERN
5.40-15 E. 292

N. 29-20 W. 305

1.55 ACRES
6-A

N. 20-58 W. 326.5

1.69 ACRES
6-B

THIS LINE CALCULATED THIS LINE N. 73-06 E. 12.53

1.8

644.5

S. 67-09 W.

206

444

206

3.23 ACRES

N. 45-15 W.

15 E.

2.1