


19739
AUG 3 1955

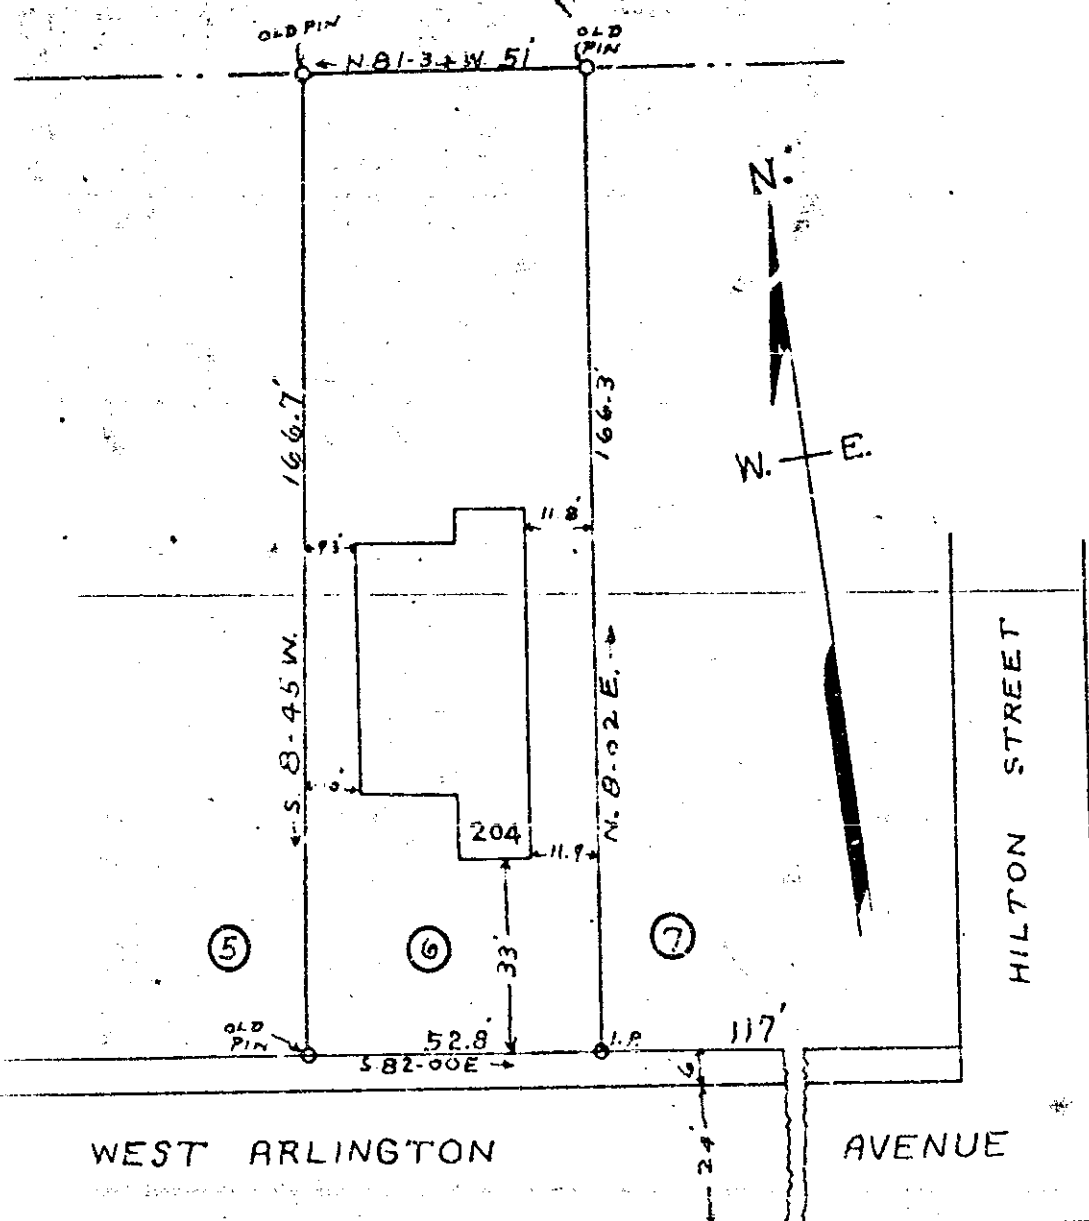

WEST ARLINGTON

AVENUE

HILTON STREET

PROPERTY OF

FRED - E - GLENN

LOCATED 204 WEST ARLINGTON AVENUE GREER
CHICK SPRINGS • TOWNSHIP • GREENVILLE • COUNTY •
SOUTH • CAROLINA •

SCALE: 1" = 30 • FEET • AUGUST • 2 • 1955

This is to certify that on August 1st 1955 I surveyed the property shown on this plat, and the same is correctly known as lot no. 6 on Flat of property of Blasters, which was made by H. B. Brockman, surveyor September 2nd 1955 (plat not recorded), and that the property lines, walls and buildings shown on said plat do not encroach on any lot on adjacent street or property, and that no adjacent buildings or walls encroach on the lot or said premises.

H. B. Brockman