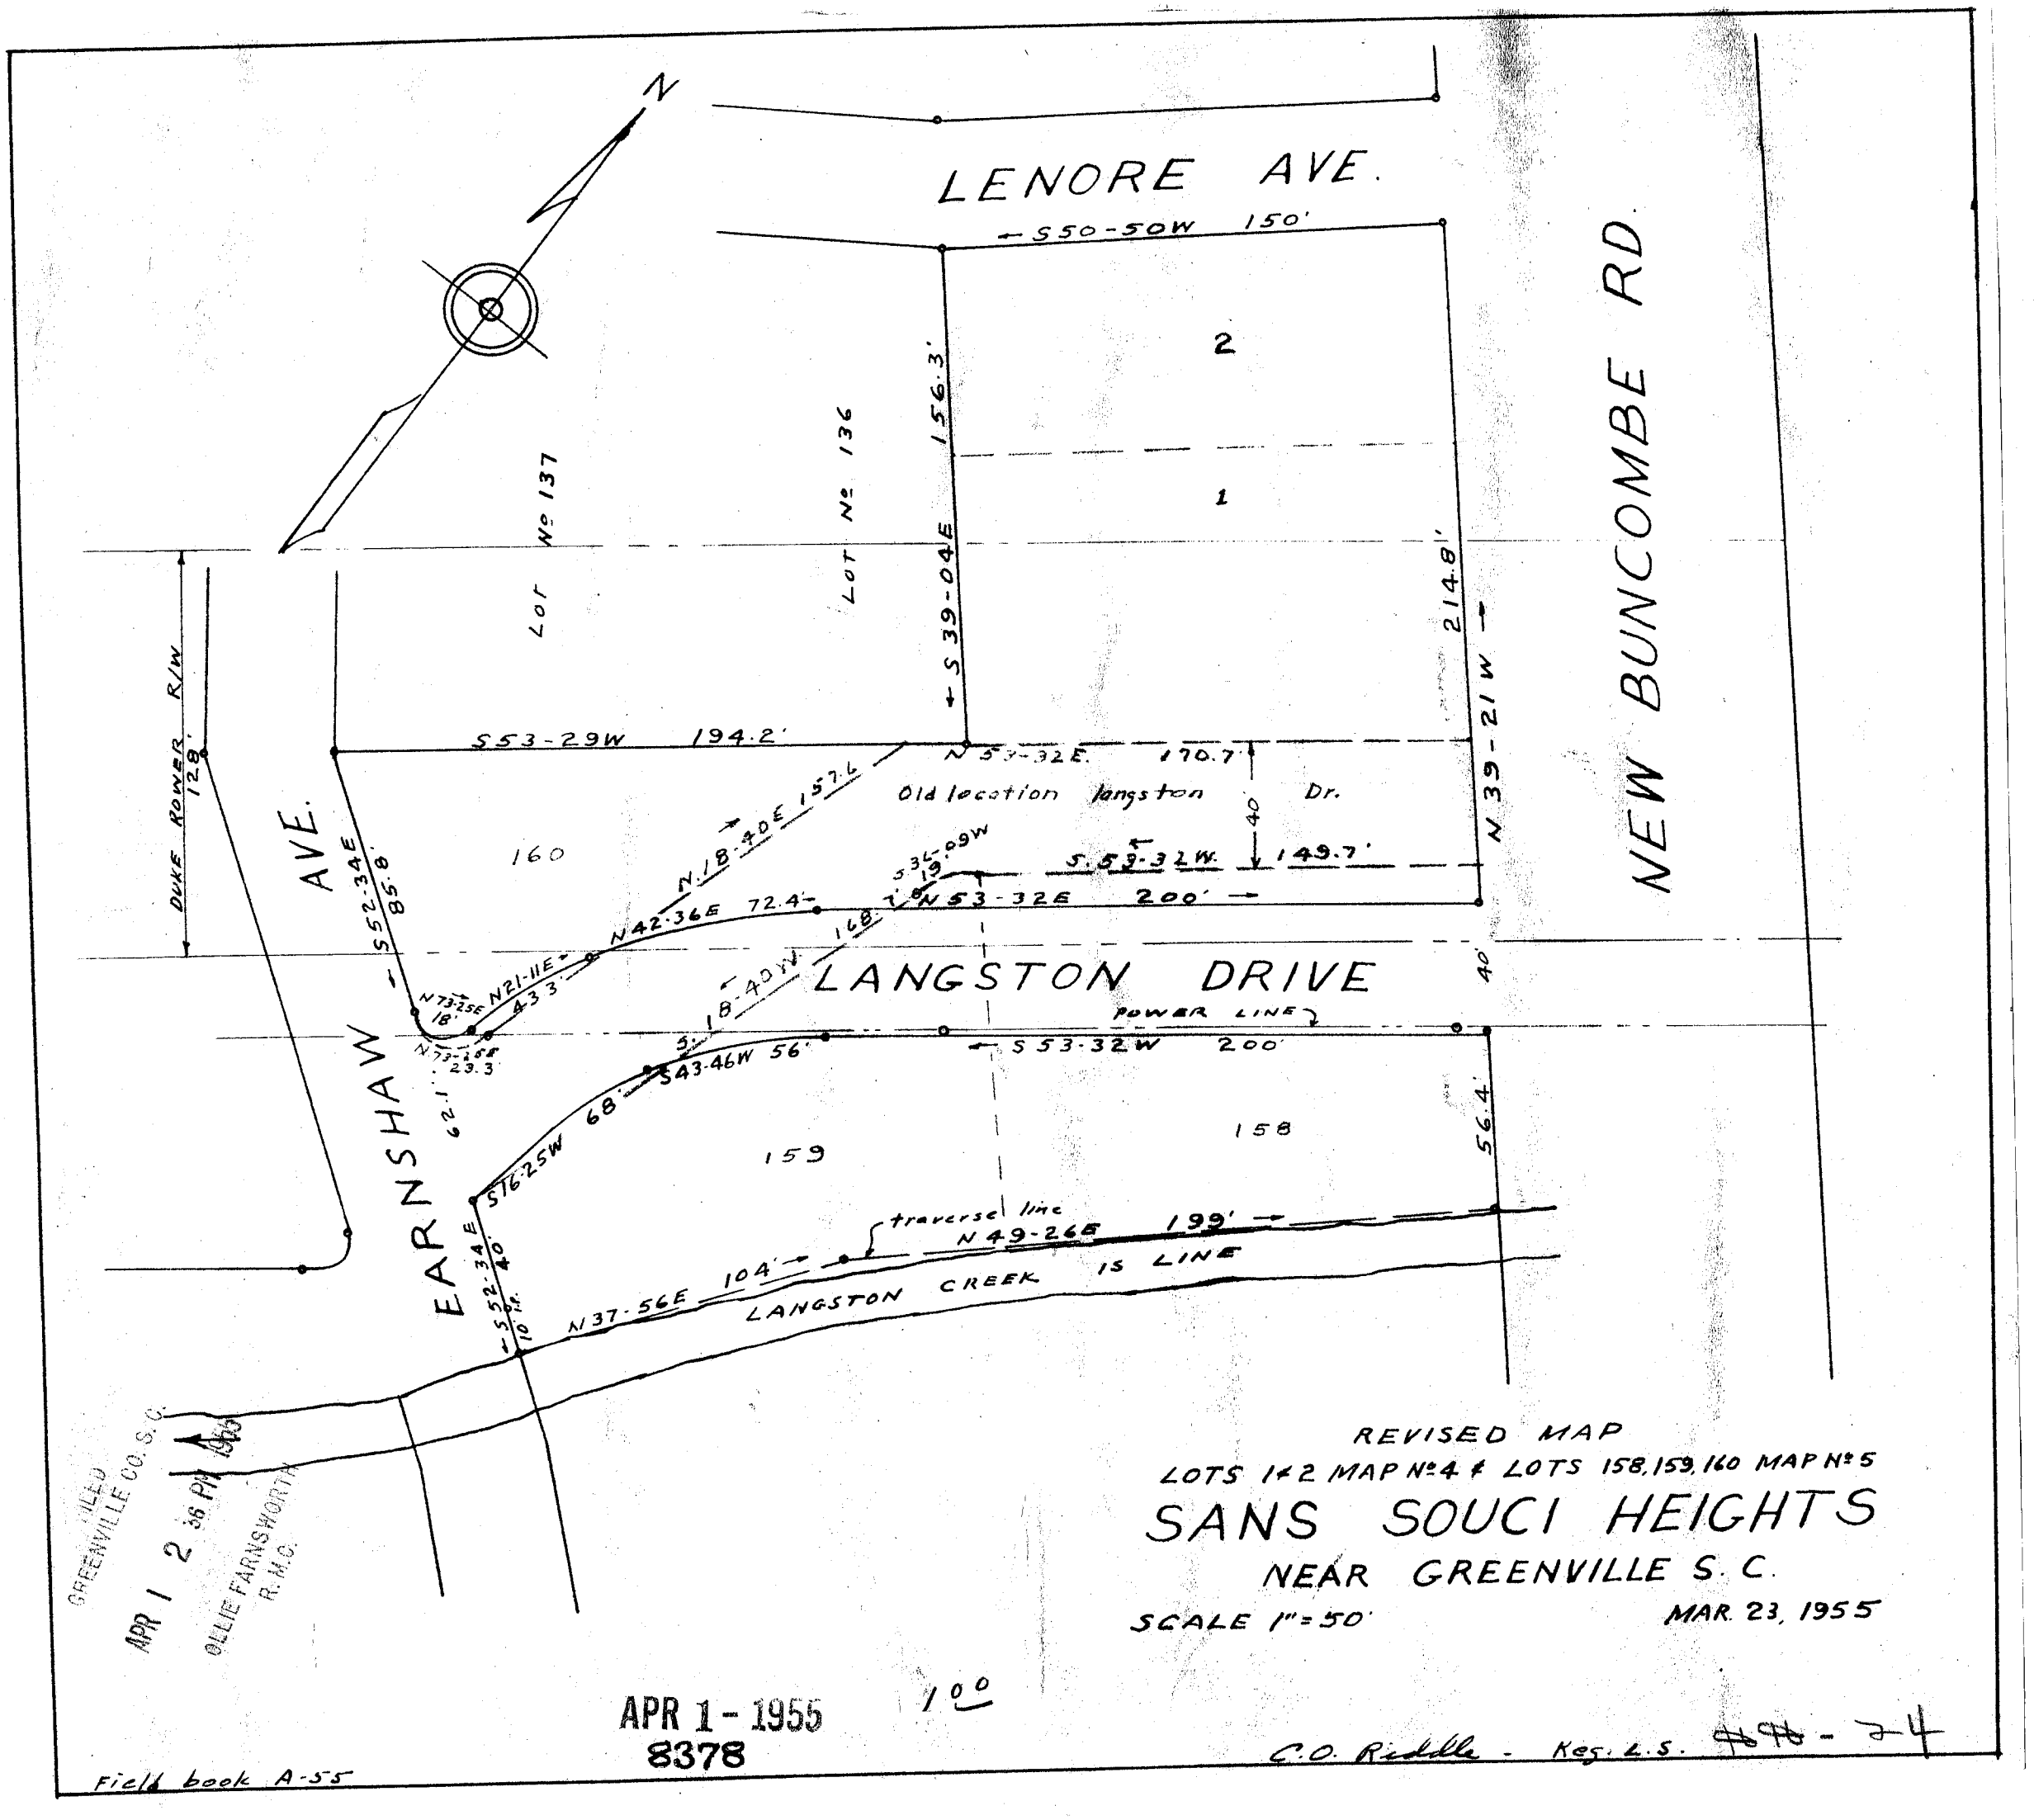

#8378 Filed This 1 day of April 1955
And Recorded in Vol. ## Page 24 M.
Ollie Farnsworth
Register Mesne Conveyance Greenville County, S. C.