


Plat Book HH, Page 85A

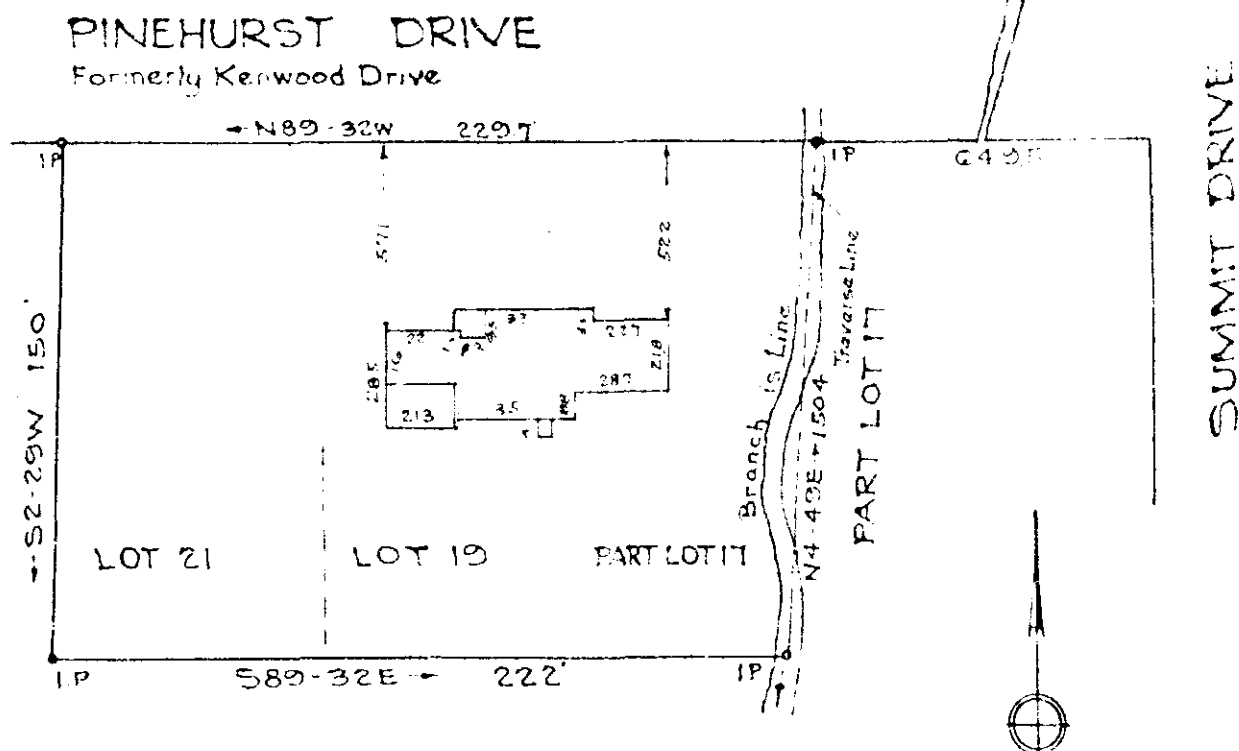

PROPERTY OF
HAZEL V. BRAZELL
 GREENVILLE S. C.
 Scale 1/60 Aug 1951

This is to certify that on the 16th day of August, 1951, I surveyed the property shown on this plat; being known as Lots 21-19- and part of Lot No. 17 on plat of Kenwood Place, Recorded in Plat Book K pages 104-105, Office of R. M. C. Greenville Co., S. C.; and that the property lines, walls and buildings are as shown hereon; that the buildings located on said lots do not encroach or project on adjacent streets or property; and that no adjacent buildings or walls encroach or project on said premises.

MAY 3 1954

R. L. Hart
 Registered.

267

9805 Filed This 3 day of May 1954
 and recorded in Vol. 107 Page 85 at 10
Olivia Farnsworth
 Register Marine Conveyance Greenville County, S. C.