


Application 170313
H. Hoke Smith

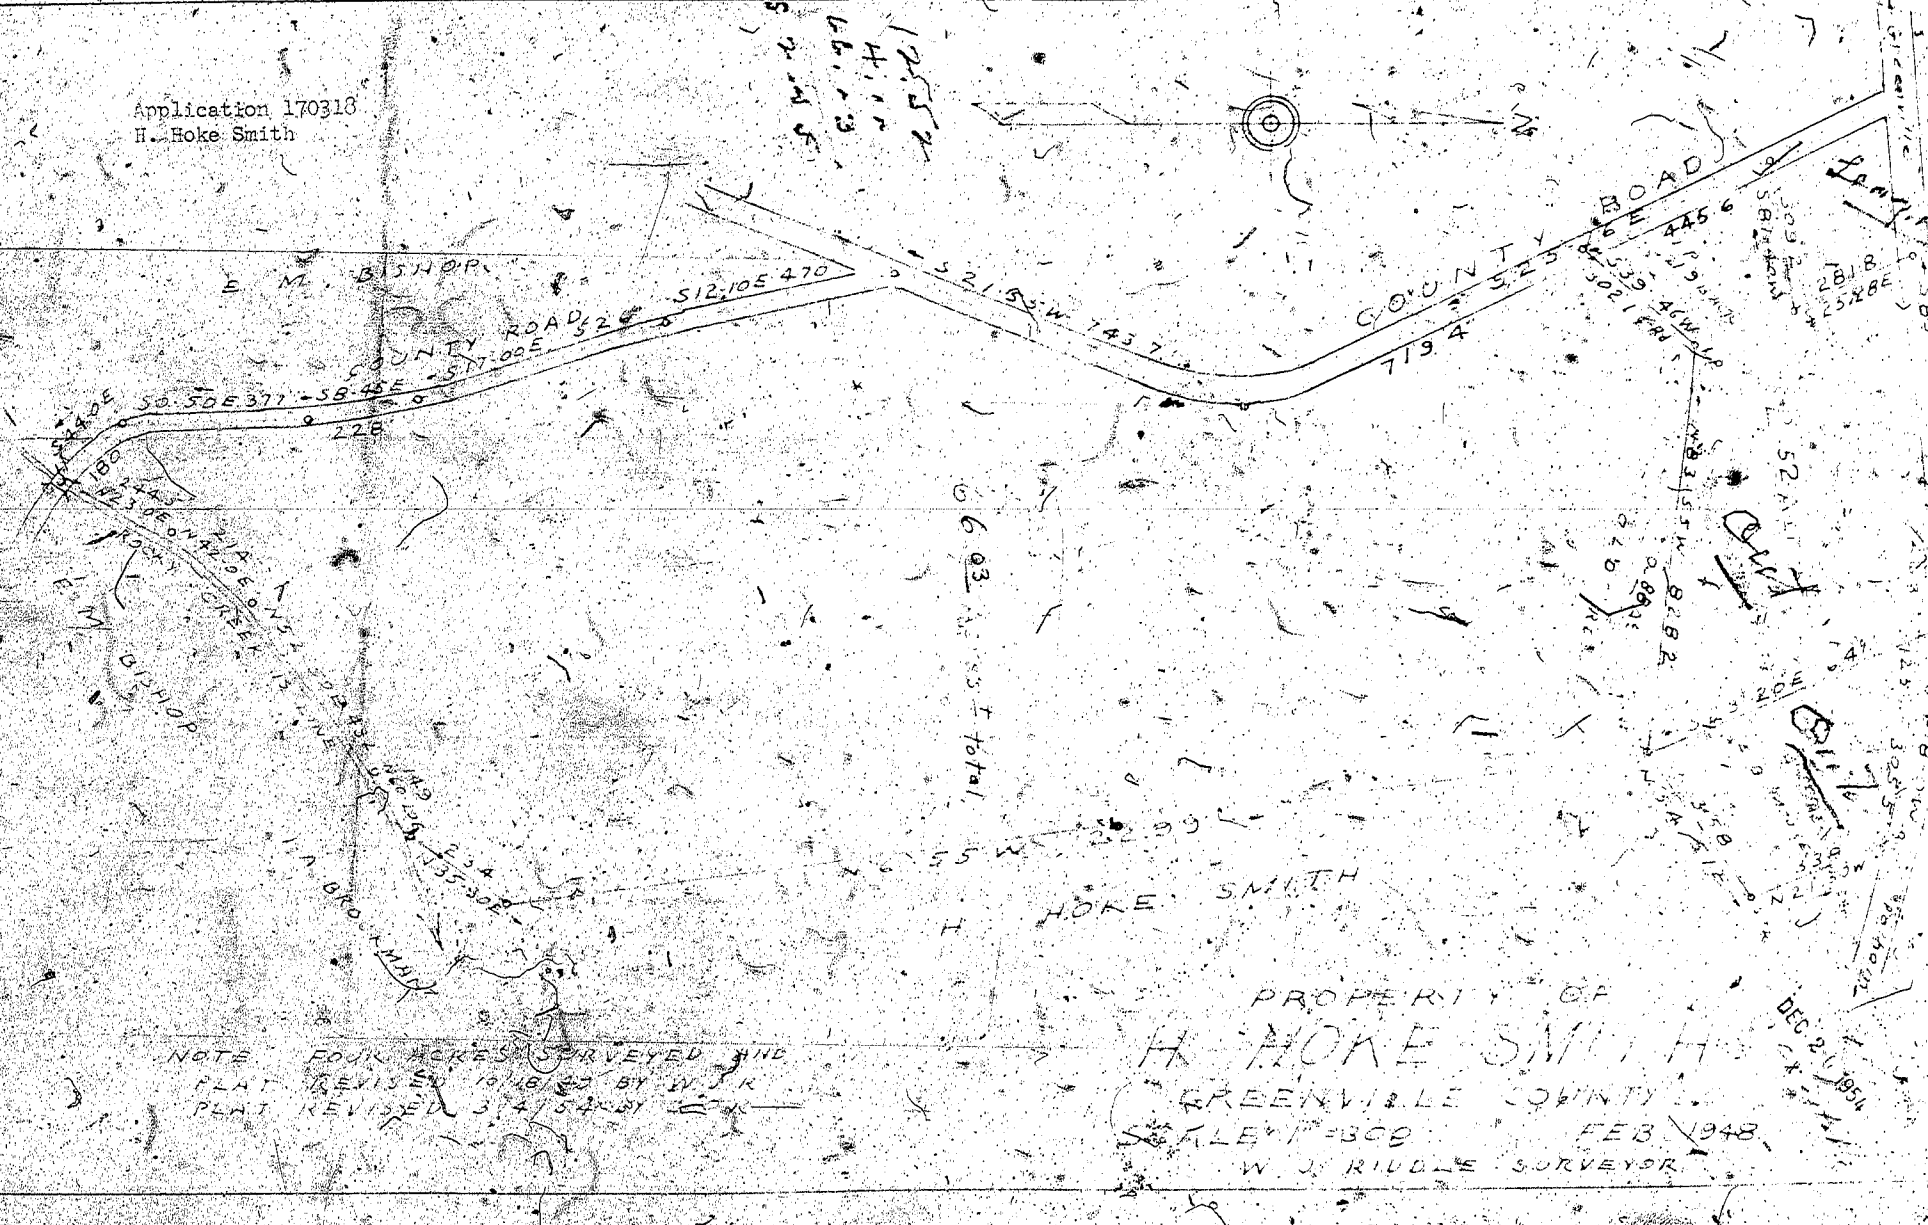

NOTE FOUR ACRES SURVEYED AND

PROPERTY OF
H. HOKE SMITH
GREENVILLE COUNTY
W. J. RIDDLE SURVEYOR

DEC 21 1954

BAD COPY

#29765 Plat this 29 day of Dec 1954
and recorded in Vol II Page 9
G. H. Rowland
