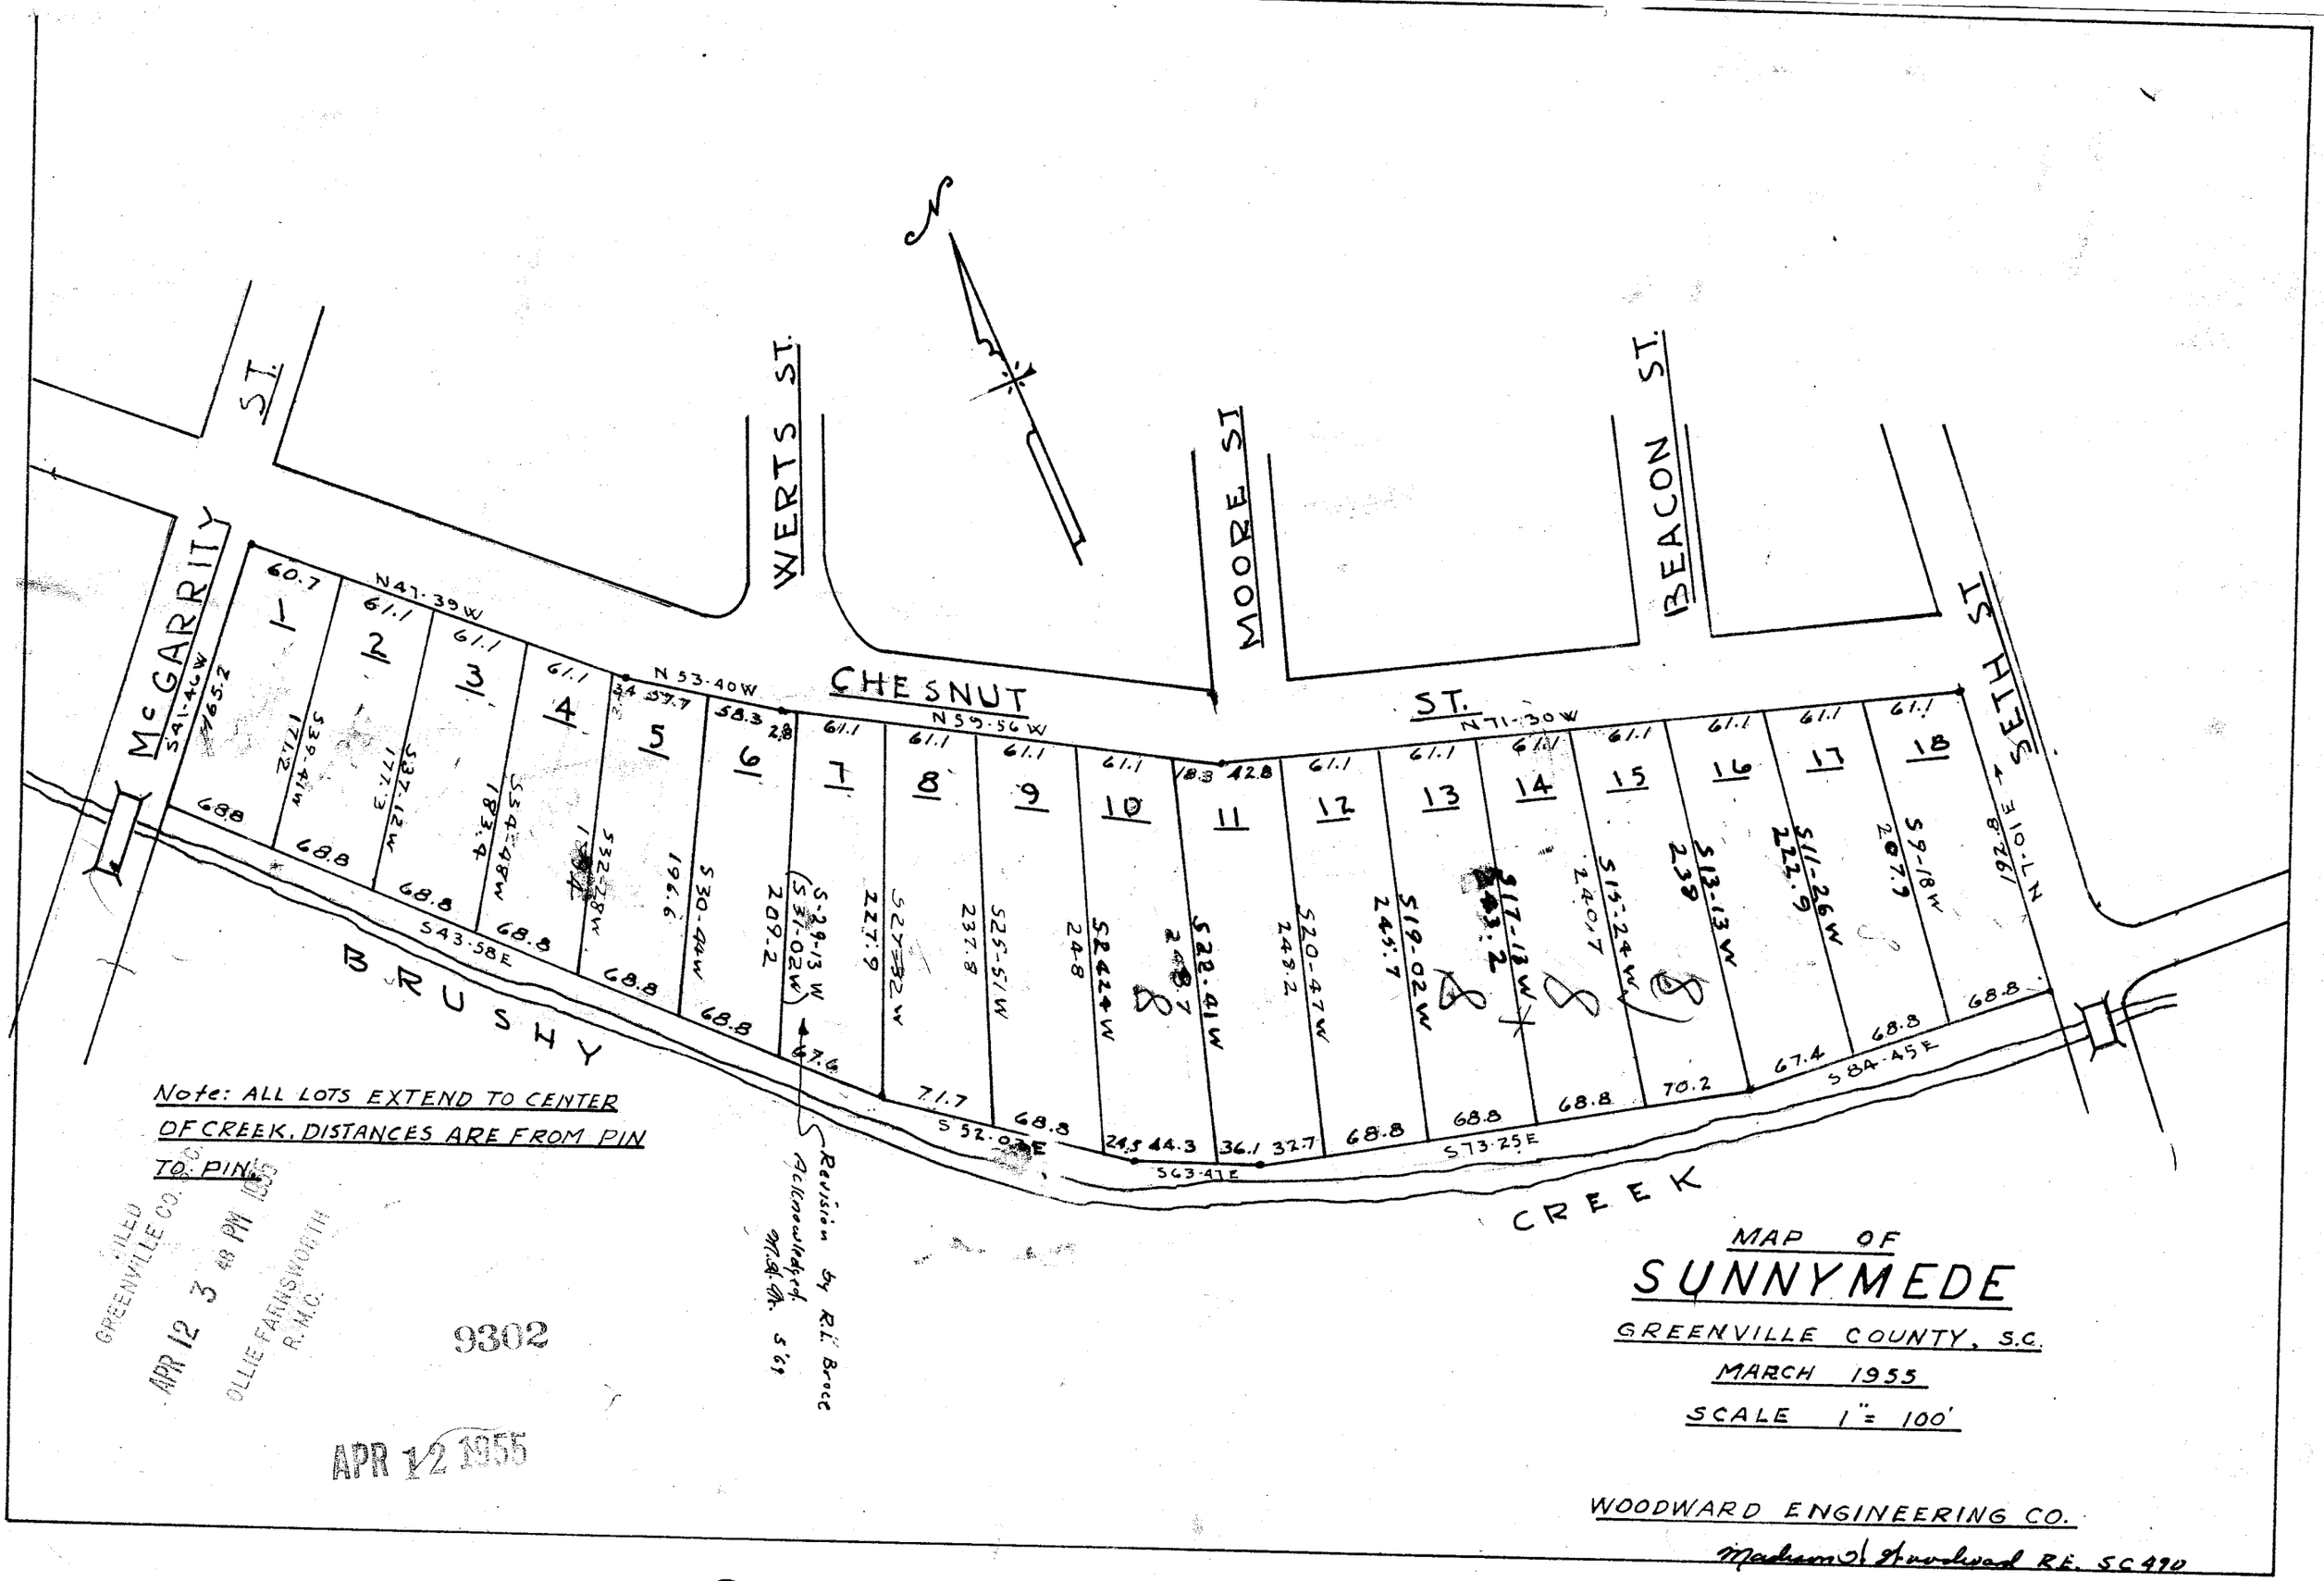

FILED
GREENVILLE CO. S.C.
APR 12 3 48 PM 1955
OLLIE FARNSWORTH
R.M.C.

9302

APR 12 1955

#9302 Filed This 12 day of April 19 55
And Recorded in Vol. II Page 109 at M.
Ollie Farnsworth
Register Mesne Conveyance Greenville County, S.C.