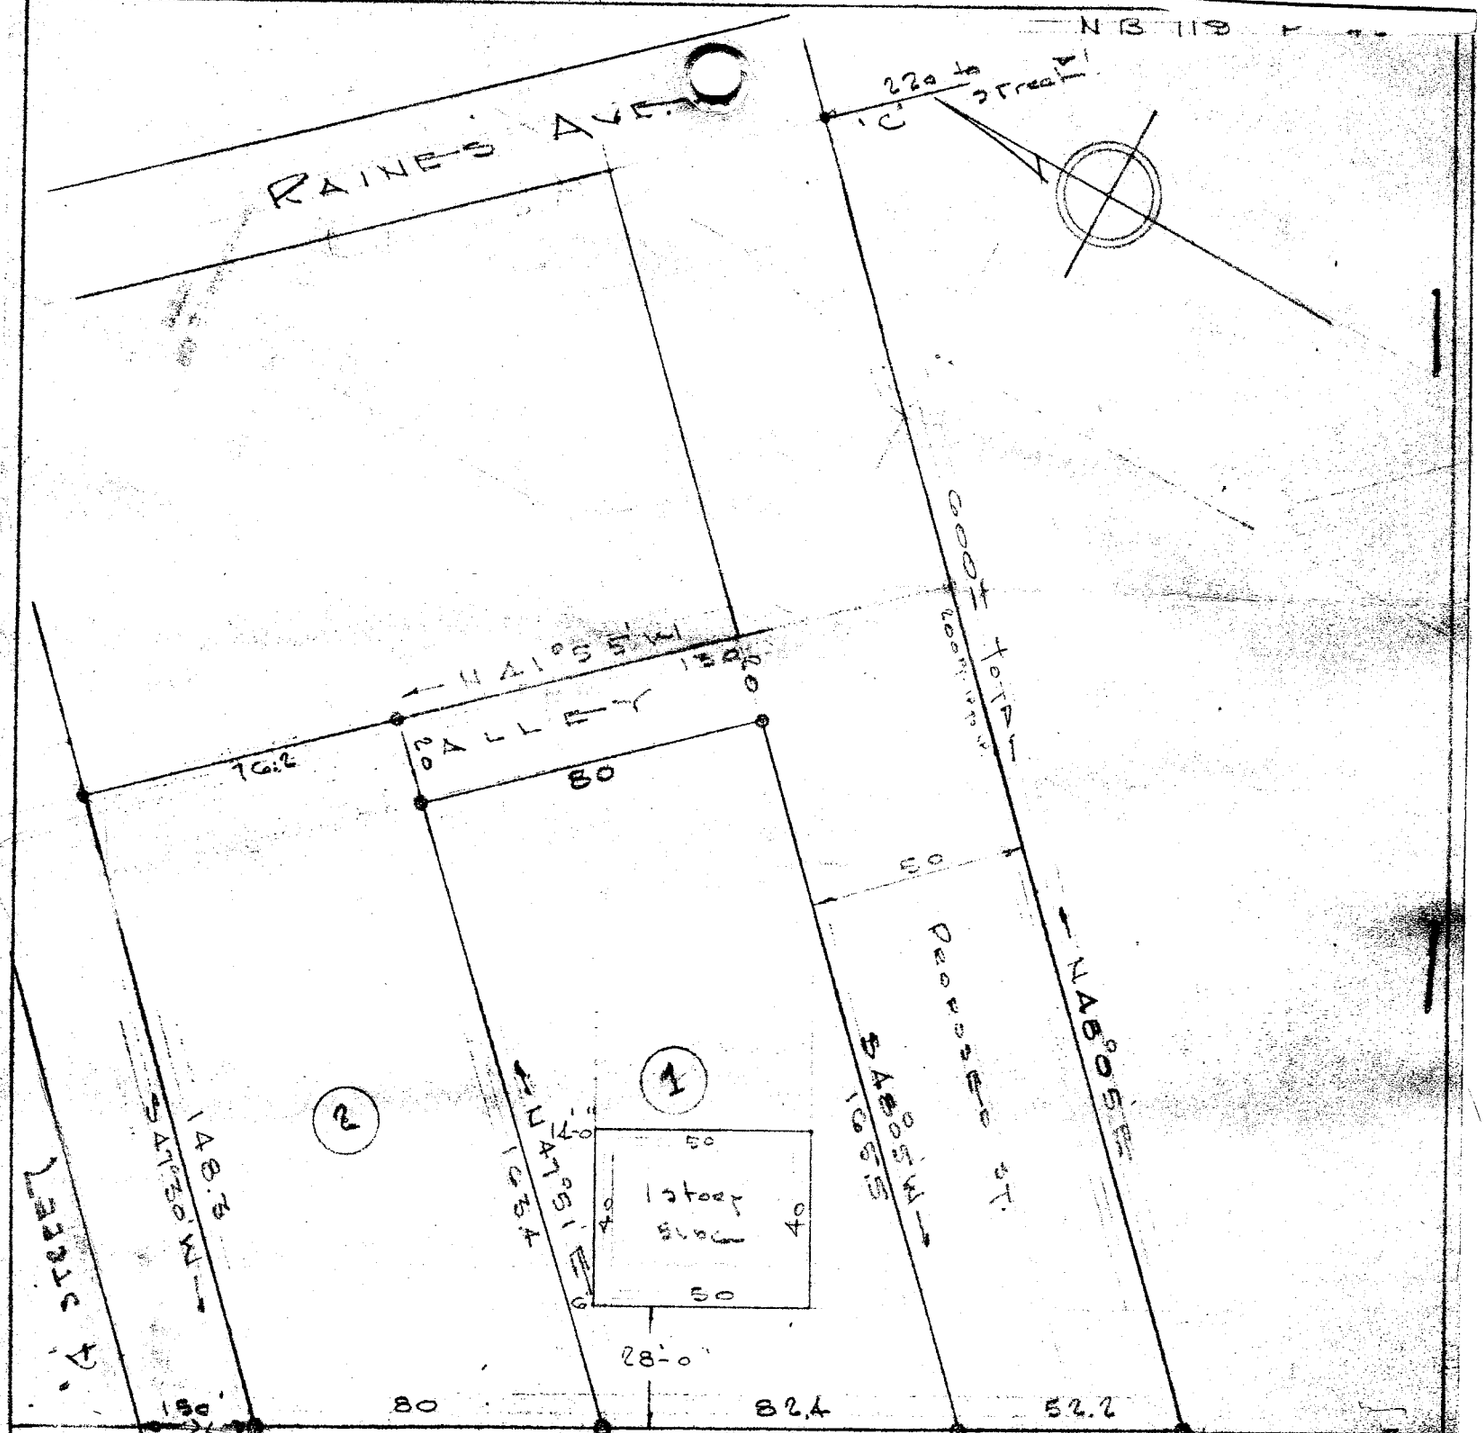

This is to certify that on the 21 day of SEPT. 1955 I surveyed the property shown on this text, and that the property lines, walls and buildings located on said lot do not encroach or project on adjacent streets or property and that no adjacent buildings or walls encroach or project on said property.

APR 27 1956

10861

II-182

PROPERTY OF W. H. ALFORD

HEAD

GREENVILLE, S.C.

SCALE: 1:40 AUGUST 1955

C. C. JONES & ASSOC. ENGINEERS GREENVILLE, S.C.

REG. ENGINEER NO. 1144 S. C.

BUILDING LOCATED SEPT. 21, 1955

10861 Filed This 27 day of April, 1956 12:41 P.M.

And Recorded in Vol. II Page 182 at ..... M.

Gillie Farnsworth

Register Mesne Conveyance Greenville County, S. C.