


12220 Filed This 12 day of May 5 '6  
 and Recorded in Vol. 27 Page 6 at  
 Ollie Farnsworth  
 Register Meane Conveyance Greenville County, S. C.

REF: PLAT OF PECAN TERRACE  

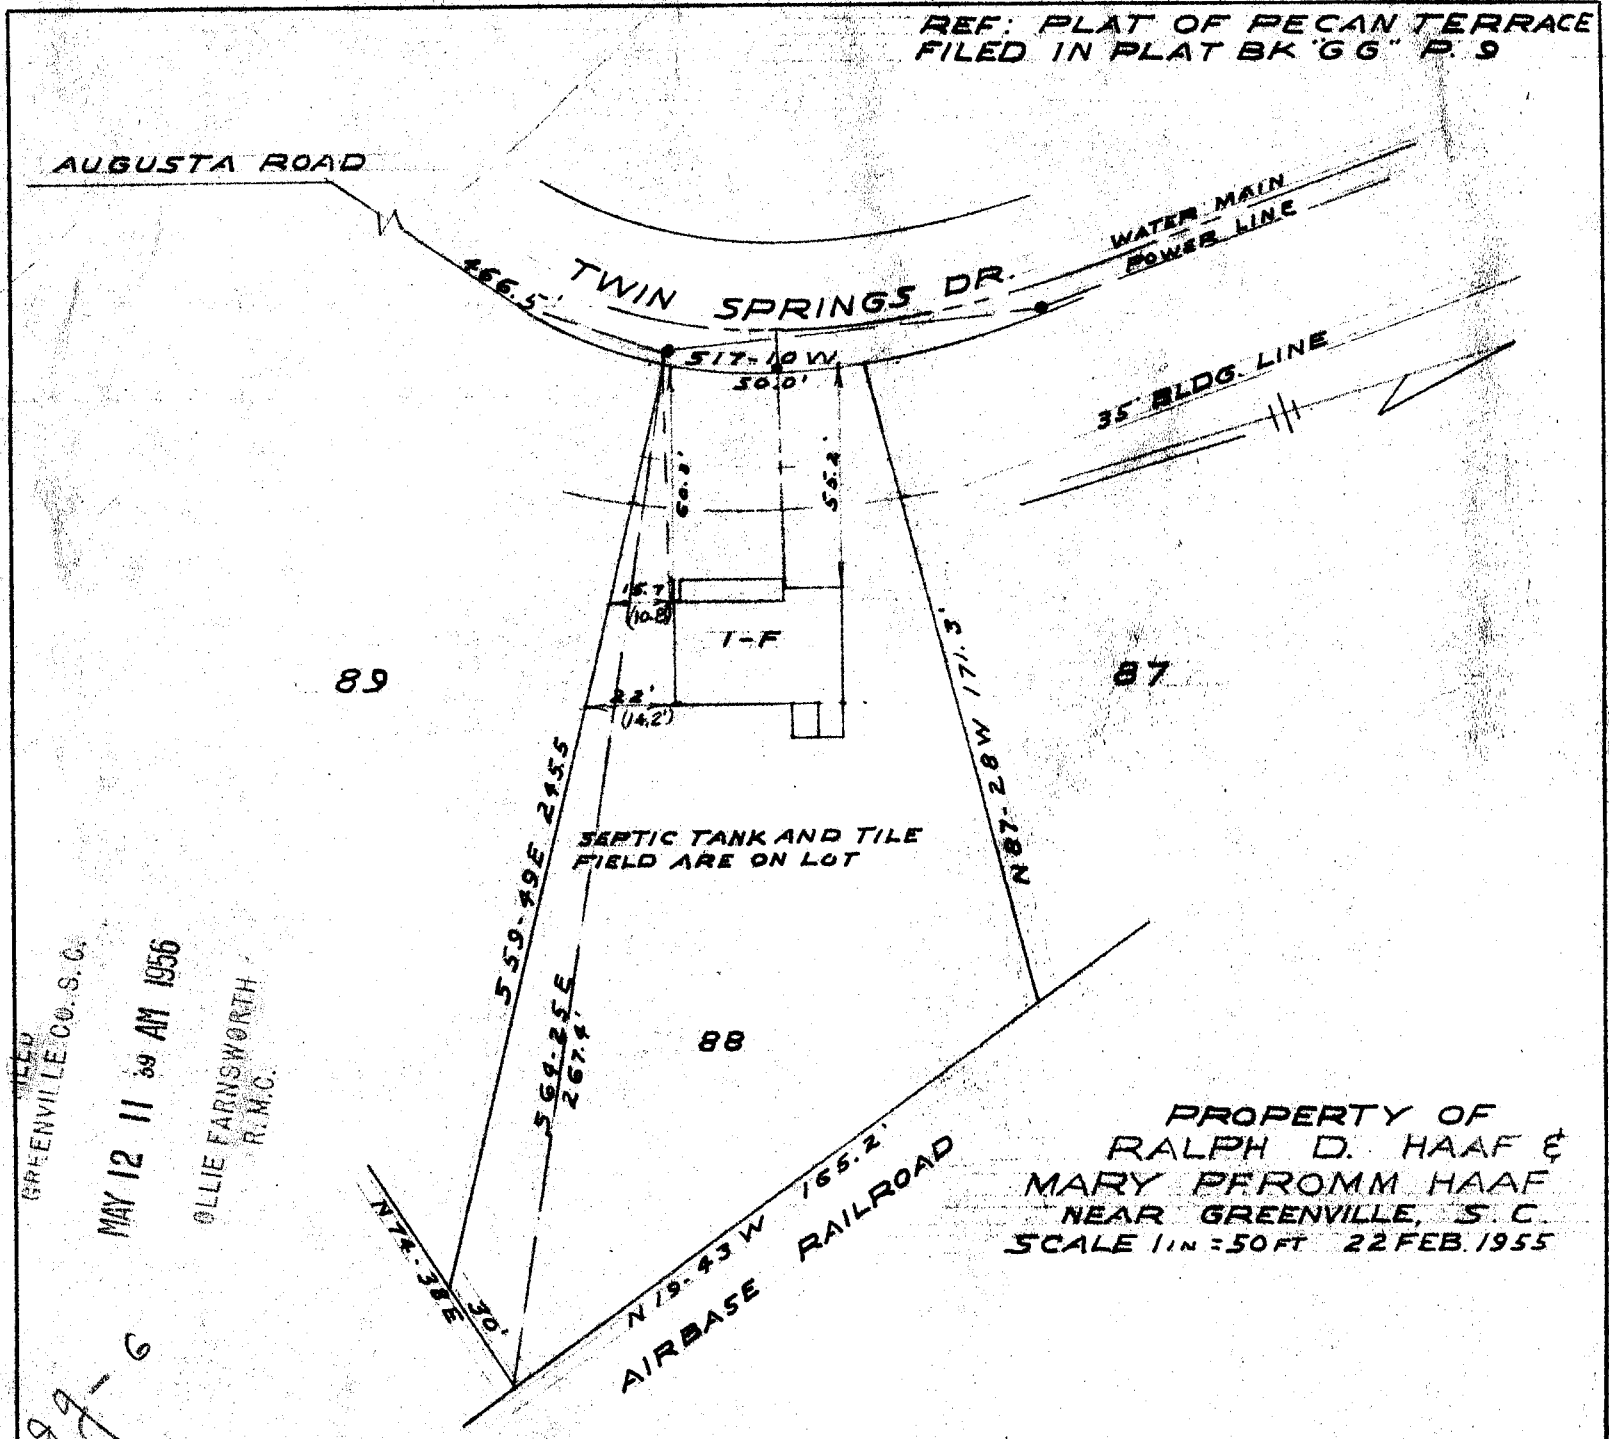

GREENVILLE CO. S. C.  
 MAY 12 11 39 AM 1956  
 OLLIE FARNSWORTH  
 R.M.C.

MAY 12 1956

This is to certify that on the 22nd day of February, 1955, I surveyed the property shown on the above plat; and that the property lines, buildings and walls are as shown hereon; that the buildings located on this lot do not encroach or project on adjacent streets or property; that no adjacent buildings or walls encroach or project on this property; and that there are no electrical lines crossing this property except as shown.

I certify that no part of the septic tank and tile field are located in the triangular portion of lot No. 88.

*Ralph D. Haaf*  
 Reg. Engineer No. 962

*Ralph D. Haaf*  
 Reg. Engineer No. 962  
 PIEDMONT ENGINEERING SERVICE  
 GREENVILLE, S. C.



Paste in 50

12220

132