


FILED
GREENVILLE CO. S. C.

OCT 3 4 06 PM '77


DONNIE S. TANKERSLEY
R.M.C.

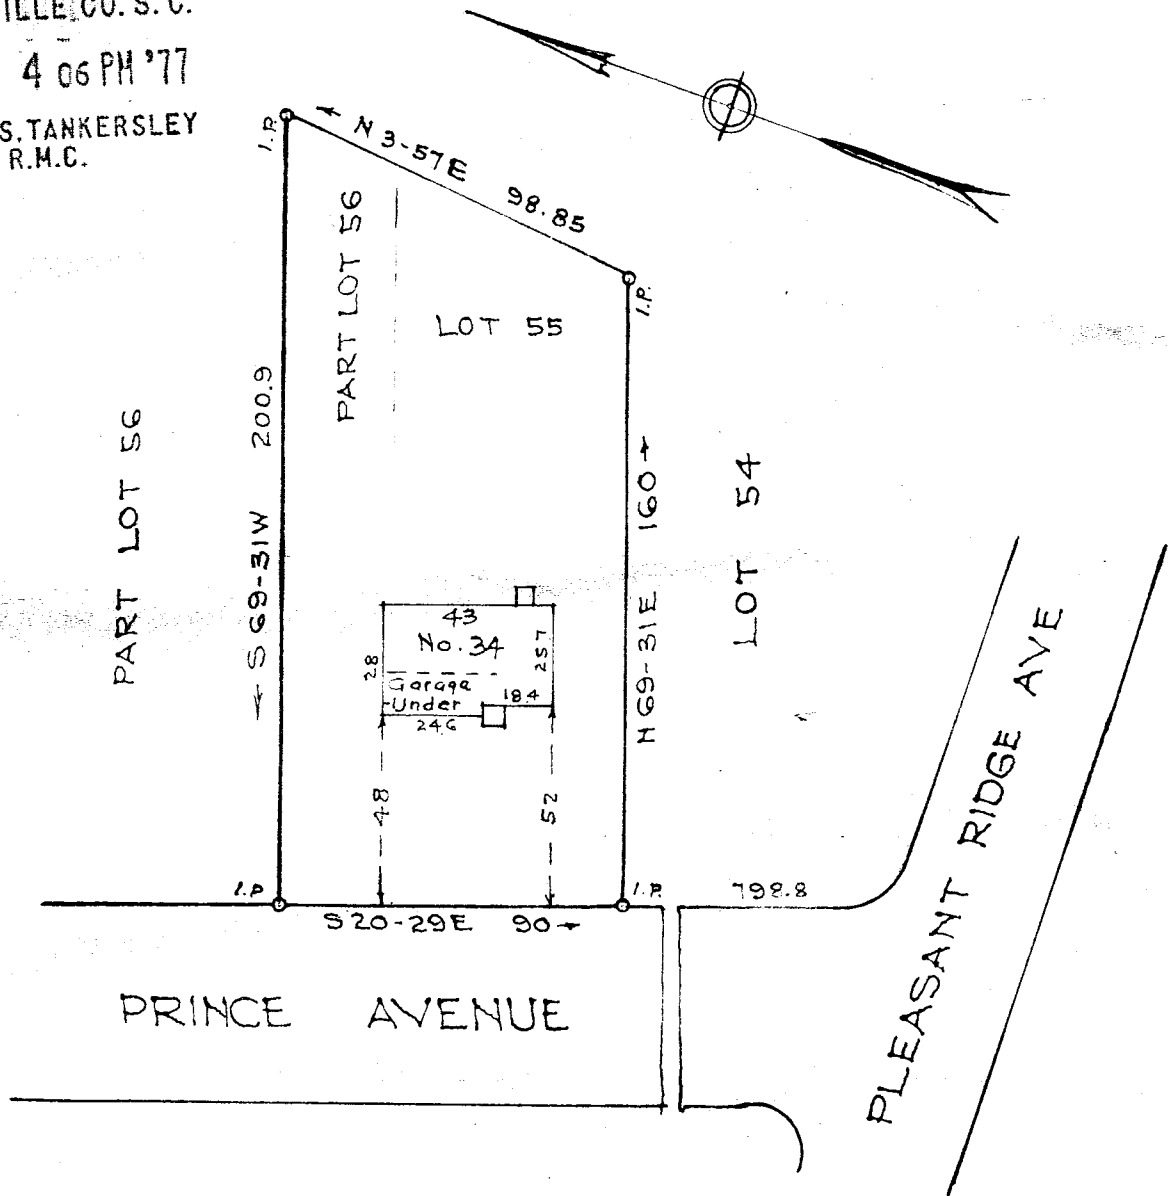

PROPERTY OF
 FORREST OAKLEY PHILLIPS JR.
 GREENVILLE S. C. 10574

Scale 1" = 50' Nov. 1955

This is to certify that on the 3rd day of November, 1955, I surveyed the property shown on this plat; being known as Lot 55 and part of Lot 56 on plat of Pleasant Valley, Recorded in Plat Book BB page 163, also as shown on plat of Forrest Oakley Phillips Jr, Recorded in Plat Book JJ page 47, Office of R.M. C. Greenville Co., S. C.; and that the property lines, walls and buildings are as shown hereon; that the buildings located on said lot do not encroach or project on adjacent streets or property; and that no adjacent buildings or walls encroach or project on said premises.

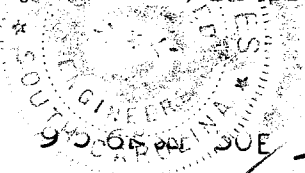

OCT 3 1977

B.W. Dalton
 Registered.

✓ JJ-47 1.00 A1

MICROFILMED