


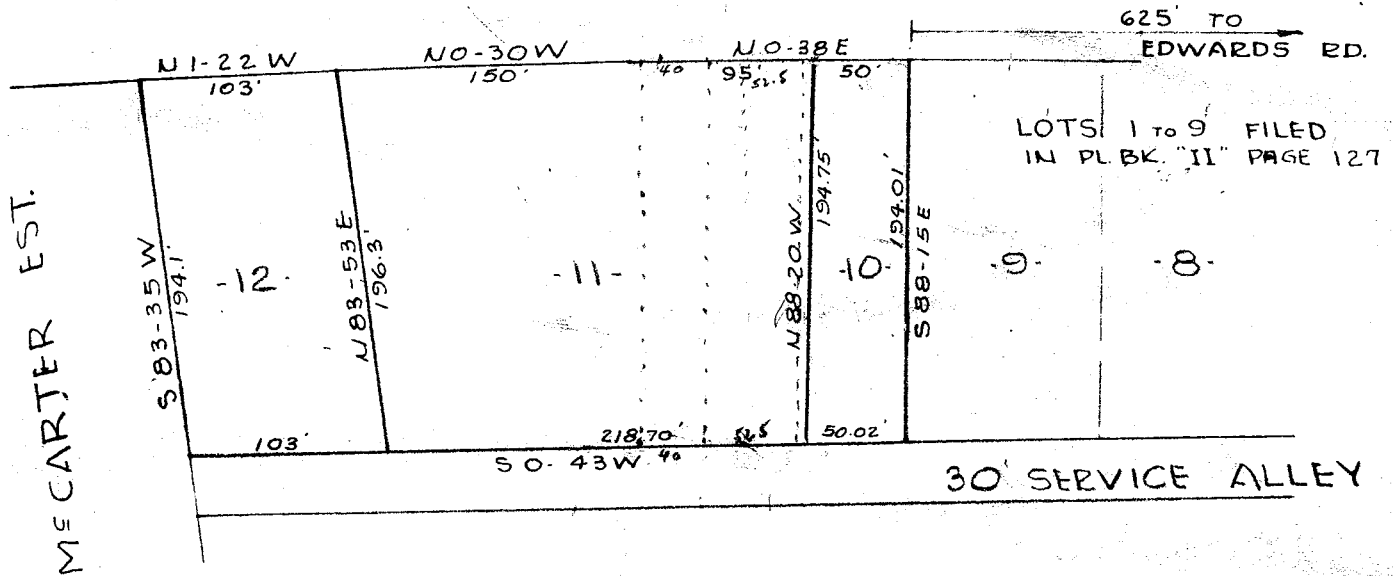

S. C. HWY. # 291

(CITY LIMITS)



PROPERTY OF
J. H. SITTON ET. AL.
 NEAR GREENVILLE, S. C.

SCALE 1" = 100 FT.

11 JAN. 1956

272
625
60

JAN 17 1956

1536



PIEDMONT ENGINEERING SERVICE
GREENVILLE, S. C.

504 parts in J.J. - 105-

2912

1536 Filed This 17 day of Jan 1956
 And Recorded in Vol. 87 Page 105

James E. Fawcett
