


Plat Book-JJ-Page 107B

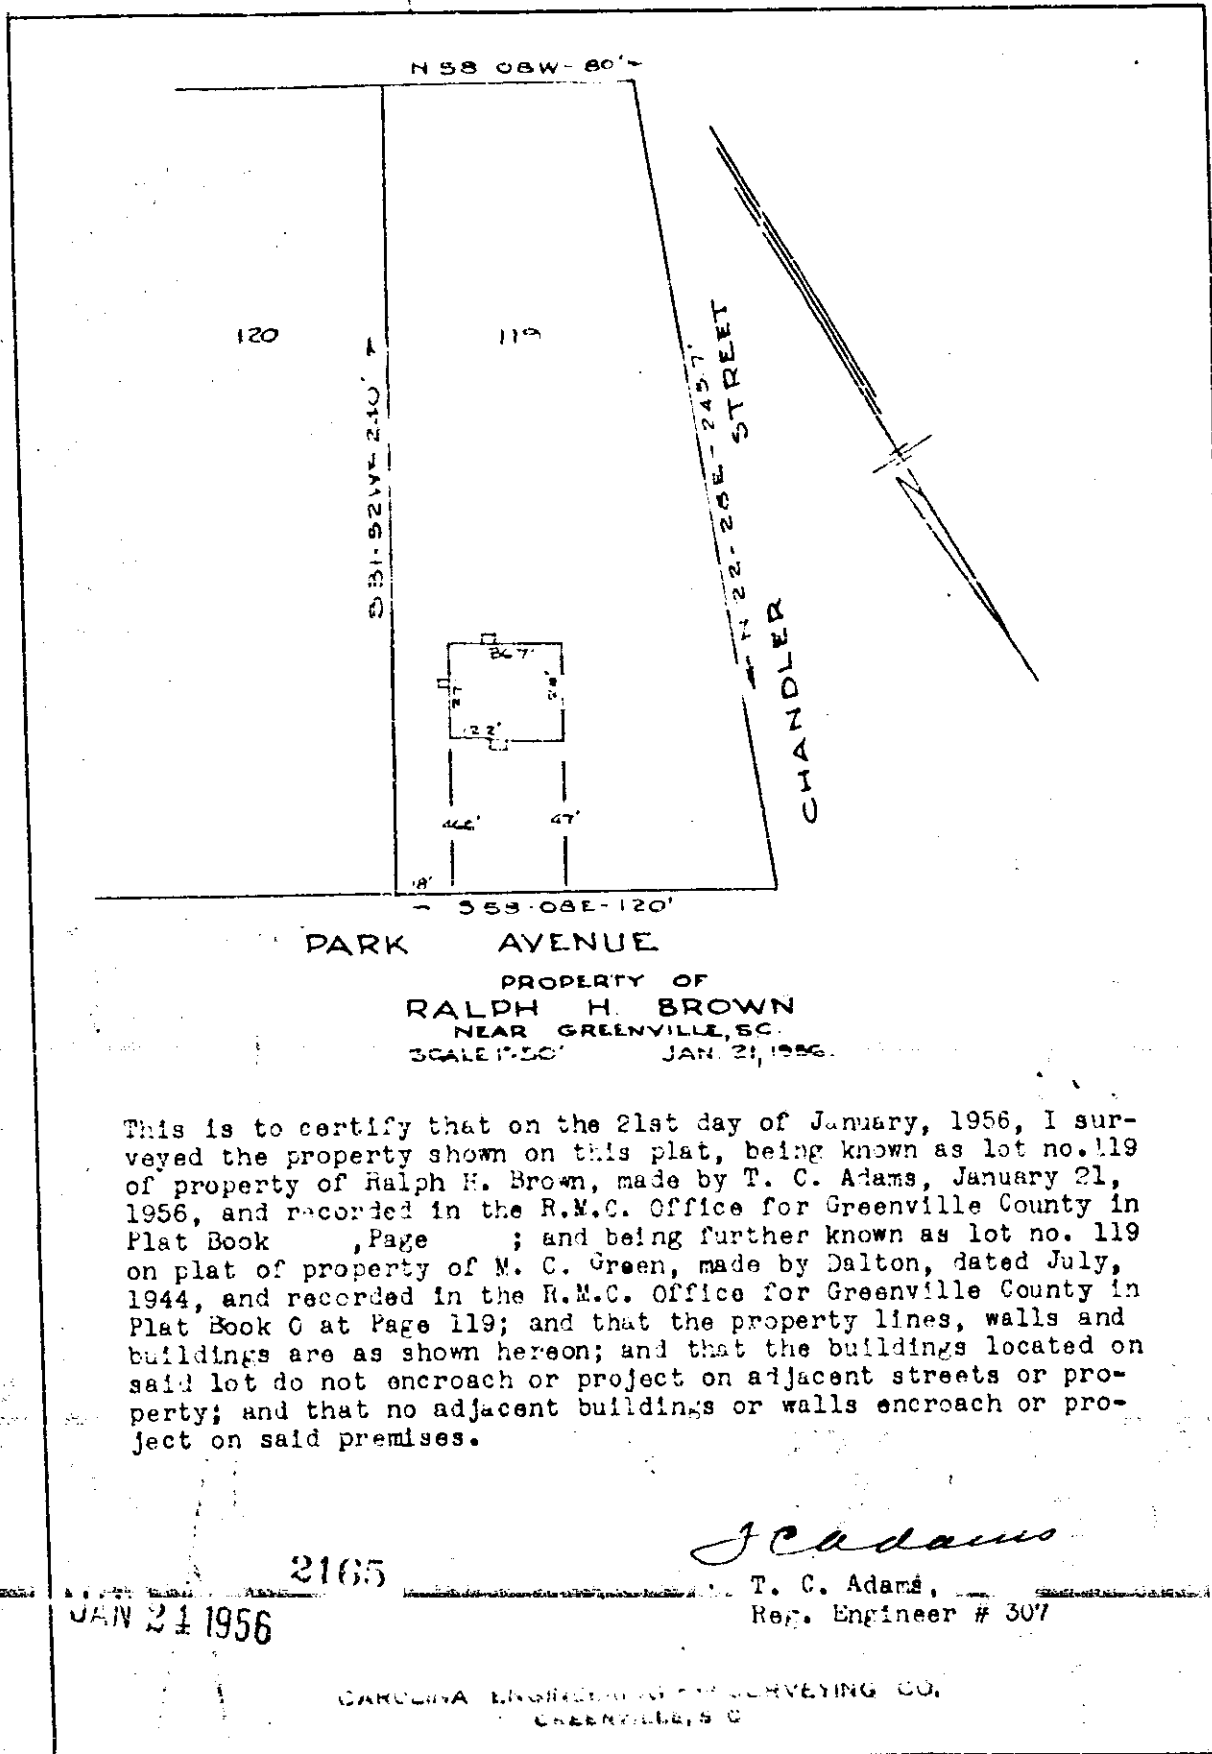

This is to certify that on the 21st day of January, 1956, I surveyed the property shown on this plat, being known as lot no. 119 of property of Ralph H. Brown, made by T. C. Adams, January 21, 1956, and recorded in the R.M.C. Office for Greenville County in Plat Book , Page ; and being further known as lot no. 119 on plat of property of M. C. Green, made by Dalton, dated July, 1944, and recorded in the R.M.C. Office for Greenville County in Plat Book C at Page 119; and that the property lines, walls and buildings are as shown hereon; and that the buildings located on said lot do not encroach or project on adjacent streets or property; and that no adjacent buildings or walls encroach or project on said premises.

2165

T. C. Adams

T. C. Adams,
Reg. Engineer # 307

JAN 21 1956

CAROLINA ENGINEERING & SURVEYING CO.
GREENVILLE, S. C.

Plat Book JJ page 107

2165 *Filed This 24 day of JAN 19 56*

and Recorded in Vol 9 of Page 107B

Carrie J. Jansworth

