Plat Book - J J - Page 153 A

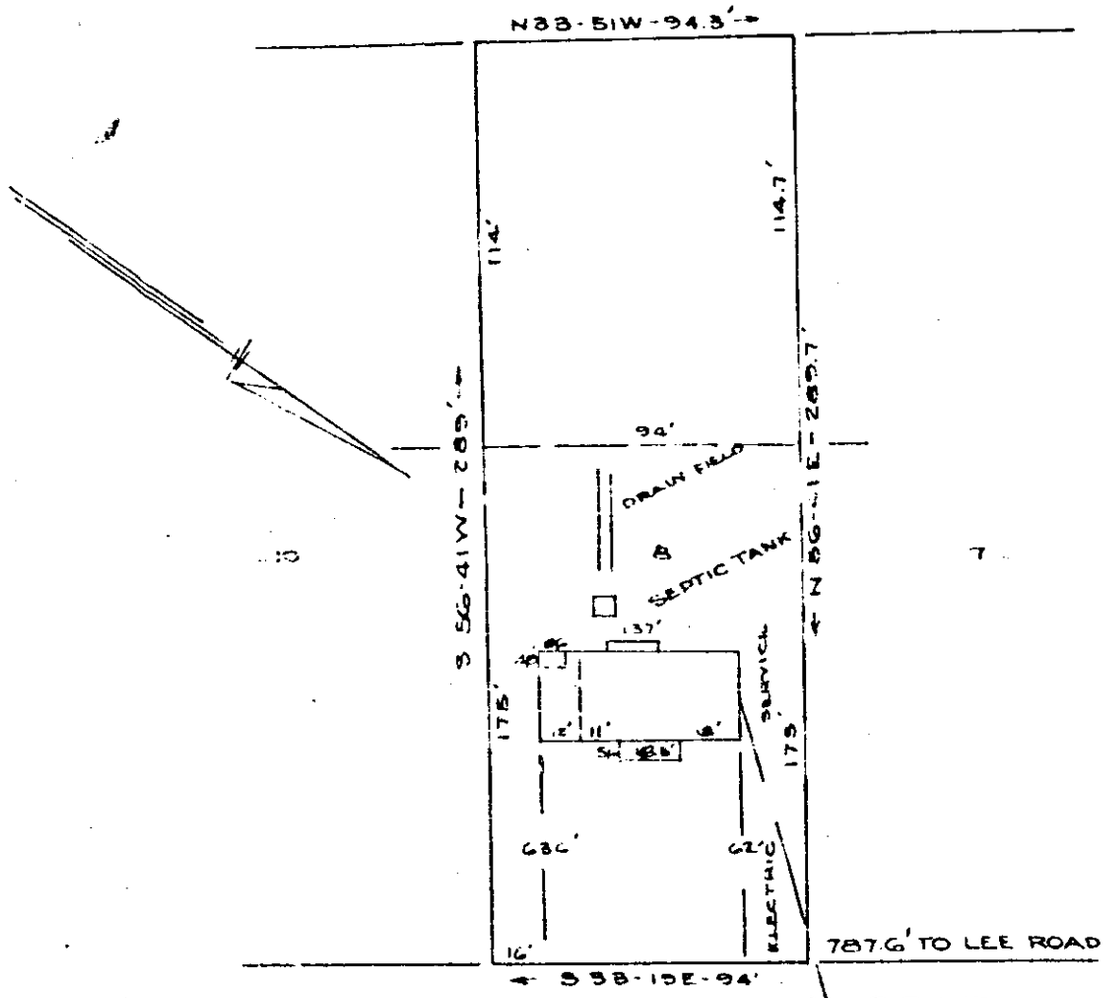

ELAINE (WATER MAIN IN STREET) DRIVE

PROPERTY OF

CARL R. BRADLEY

NEAR GREENVILLE, S.C.

JULY 2, 1956 SCALE 1" = 50'

GREENVILLE CO. S.C.
JUL 3 3 41 PM 1956
OLLIE FARNSWORTH
R.M.C.

16992

This is to certify that on the 2nd day of July, 1956 I surveyed the property shown on this plat being known as lot no. 8 and an unnumbered portion of the W. M. Edwards property and being also known as the property of Carl R. Bradley by T. C. Adams dated July 2, 1956 and recorded in Plat Book at Page , Office of the R.M.C., Greenville County, S. C.; and that the property lines, walls and buildings are as shown hereon; and that the buildings located on the said lot do not encroach or project on adjacent streets or property; and that no adjacent buildings or walls encroach or project on said premises.

T. C. Adams

T. C. Adams
Reg. Engineer # 307

CAROLINA ENGINEERING AND SURVEYING CO.
GREENVILLE, S.C.

Plat JJ-153

16992 Filed This 3 day of July 1956
And Recorded JJ - 153 at ... M.
Cecil E. Farnsworth
Register Mesne Conveyance Greenville County, S. C.