


68.7
63.9

4.8

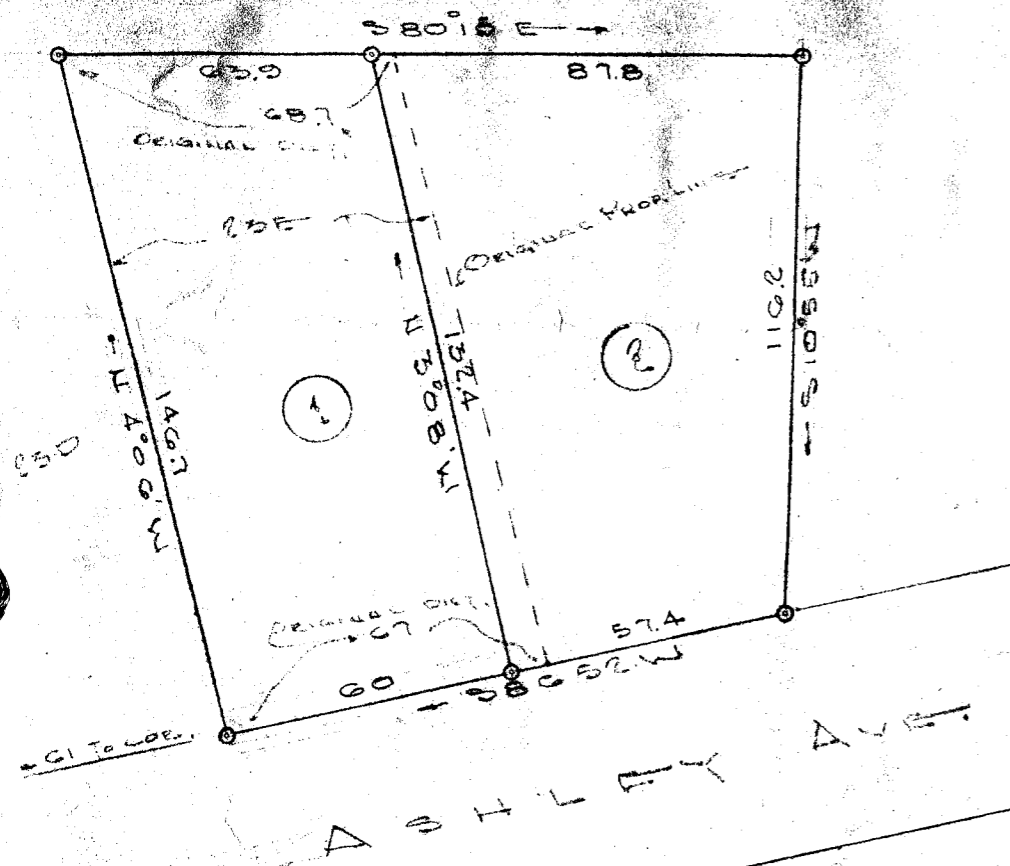

NE 121 2.10

FILED
GREENVILLE CO. S.C.
MAR 21 3 51 PM 1956
OLLIE FARNSWORTH
R.M.C.

NOTE: SEE R.M.C. PLAT BOOK C; SHEET 12;
PAGE 16 FOR ORIGINAL SUBDIVISION

MAR 21 1956

7392

.50

Iron pipe at all corners.

PROPERTY
OF
JOHN BOLT CULBERTSON
GREENVILLE, S.C.

SCALE: 1" = 40 FT. SEPT. 14, 1955

C. C. JONES & Associates
REGISTERED
GREENVILLE, S.C.

7392
Mar 21 1956
Ollie Farnsworth
R.M.C.