
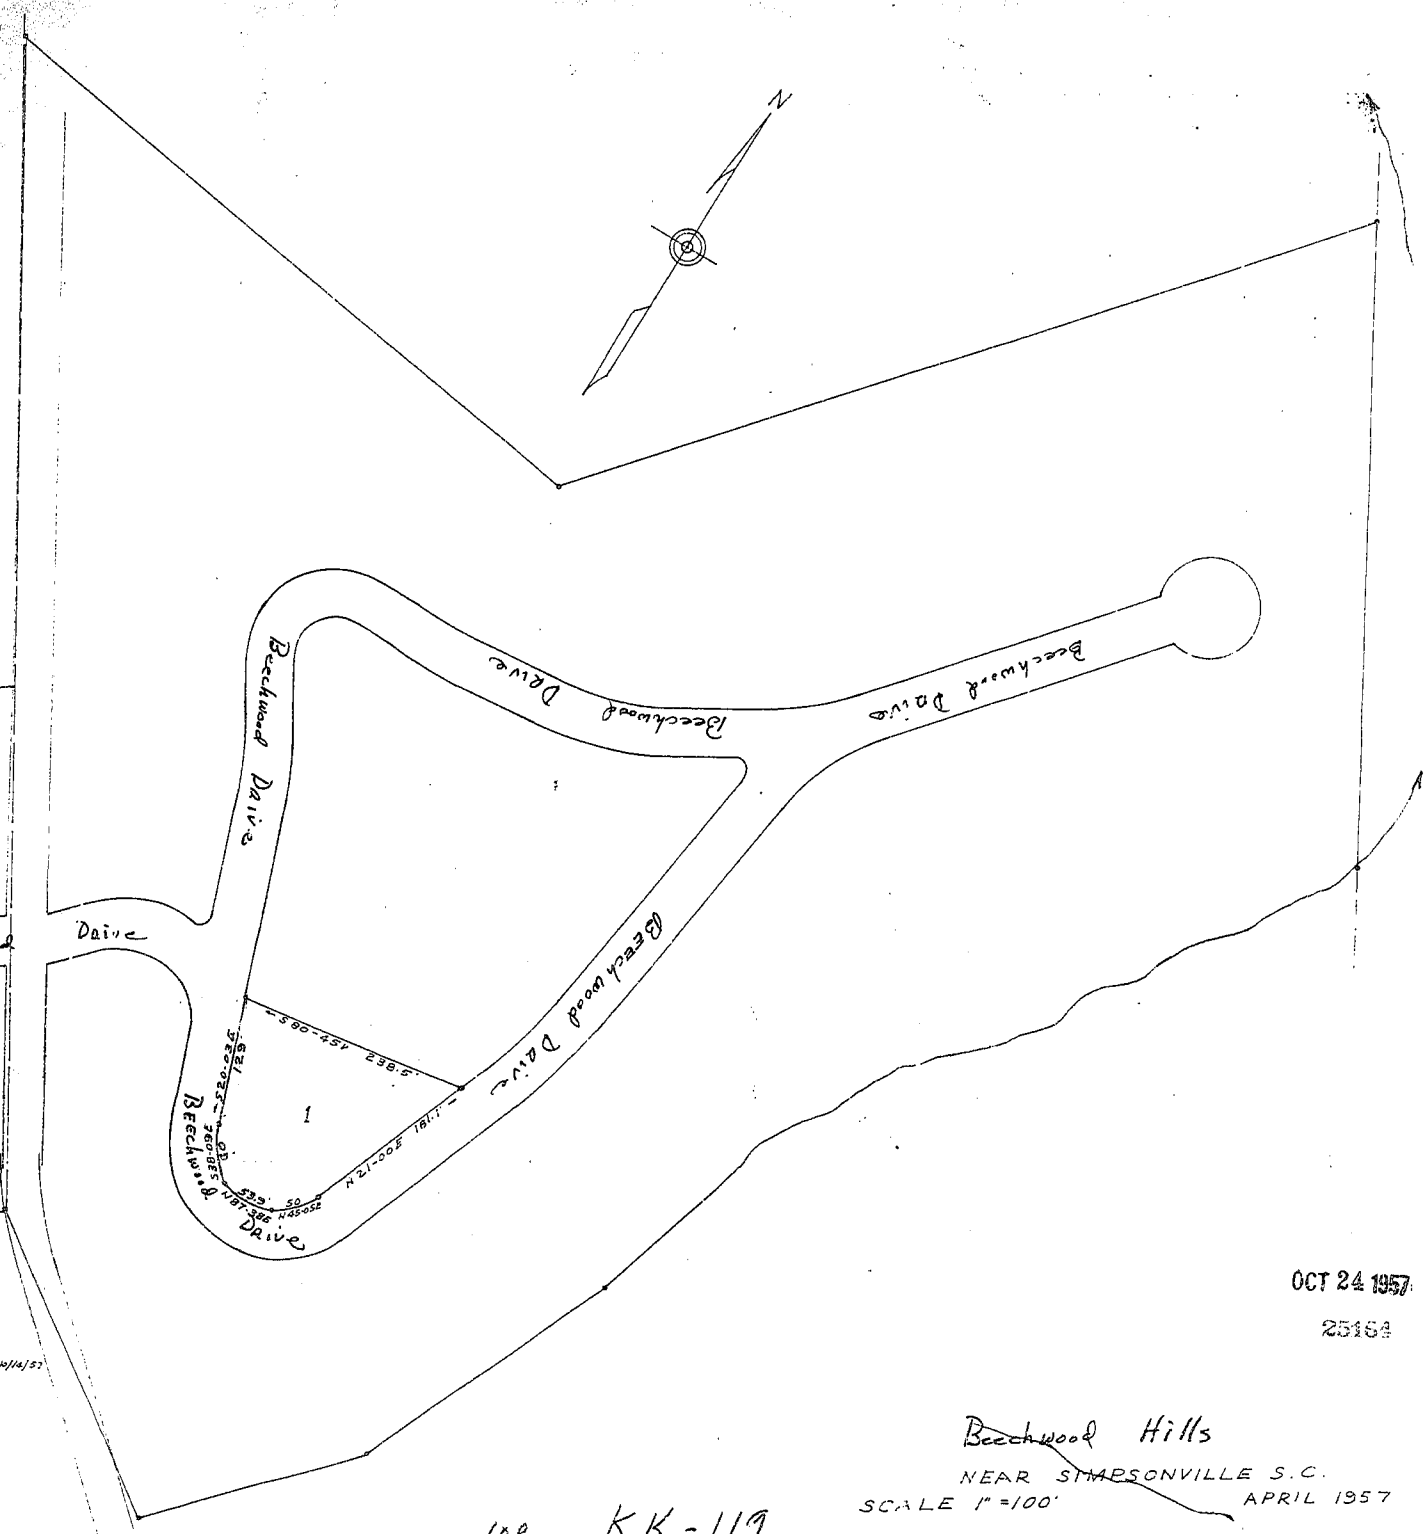
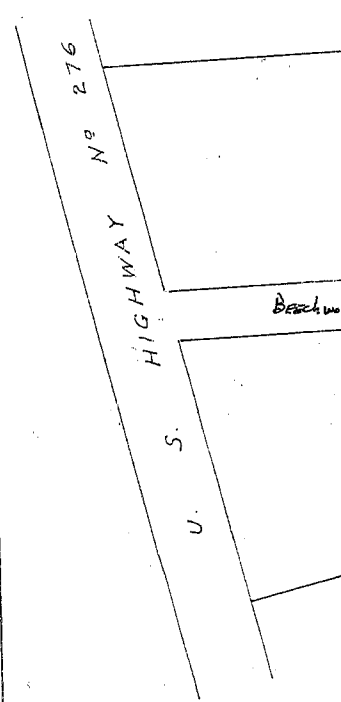


611

FILED  
GREENVILLE CO. S. C.  
OCT 24 3 52 PM 1957  
OLLIE FAIRBANKS  
R.M.C.

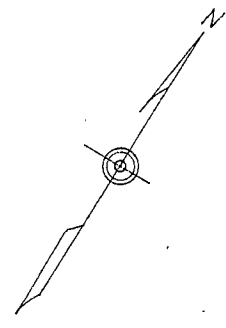

LOT NO 1 SURVEYED & PLAT REVISD 4/14/57

OCT 24 1957  
25164

Beachwood Hills  
NEAR SIMPSONVILLE S.C.  
SCALE 1"=100'  
APRIL 1957

100 KK-119

Field books A-57, C-57

25164  
