


Plat Book LL, Page 6

300 504

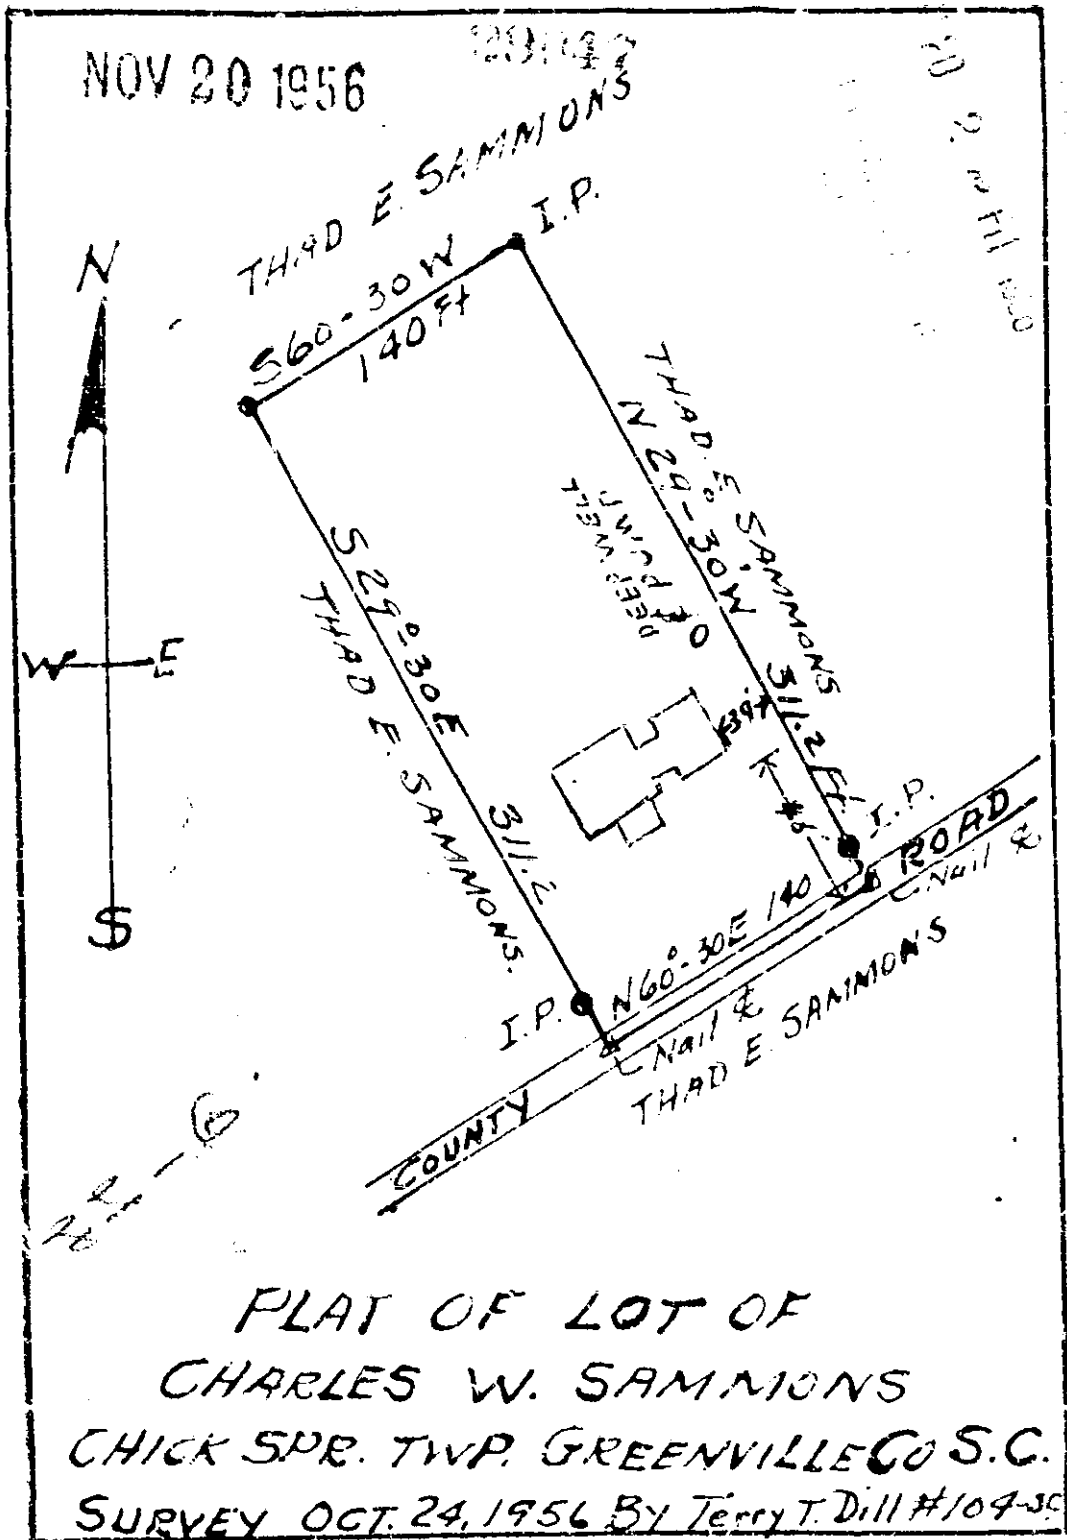

29047 Filed This 20 day of Nov. 1956

and Recorded in Vol. 55 Page 6 of 5

Charles W. Sammons

Register Name Conveyance Greenville County, S. C.