


AUG 19 6 30 AM 1960

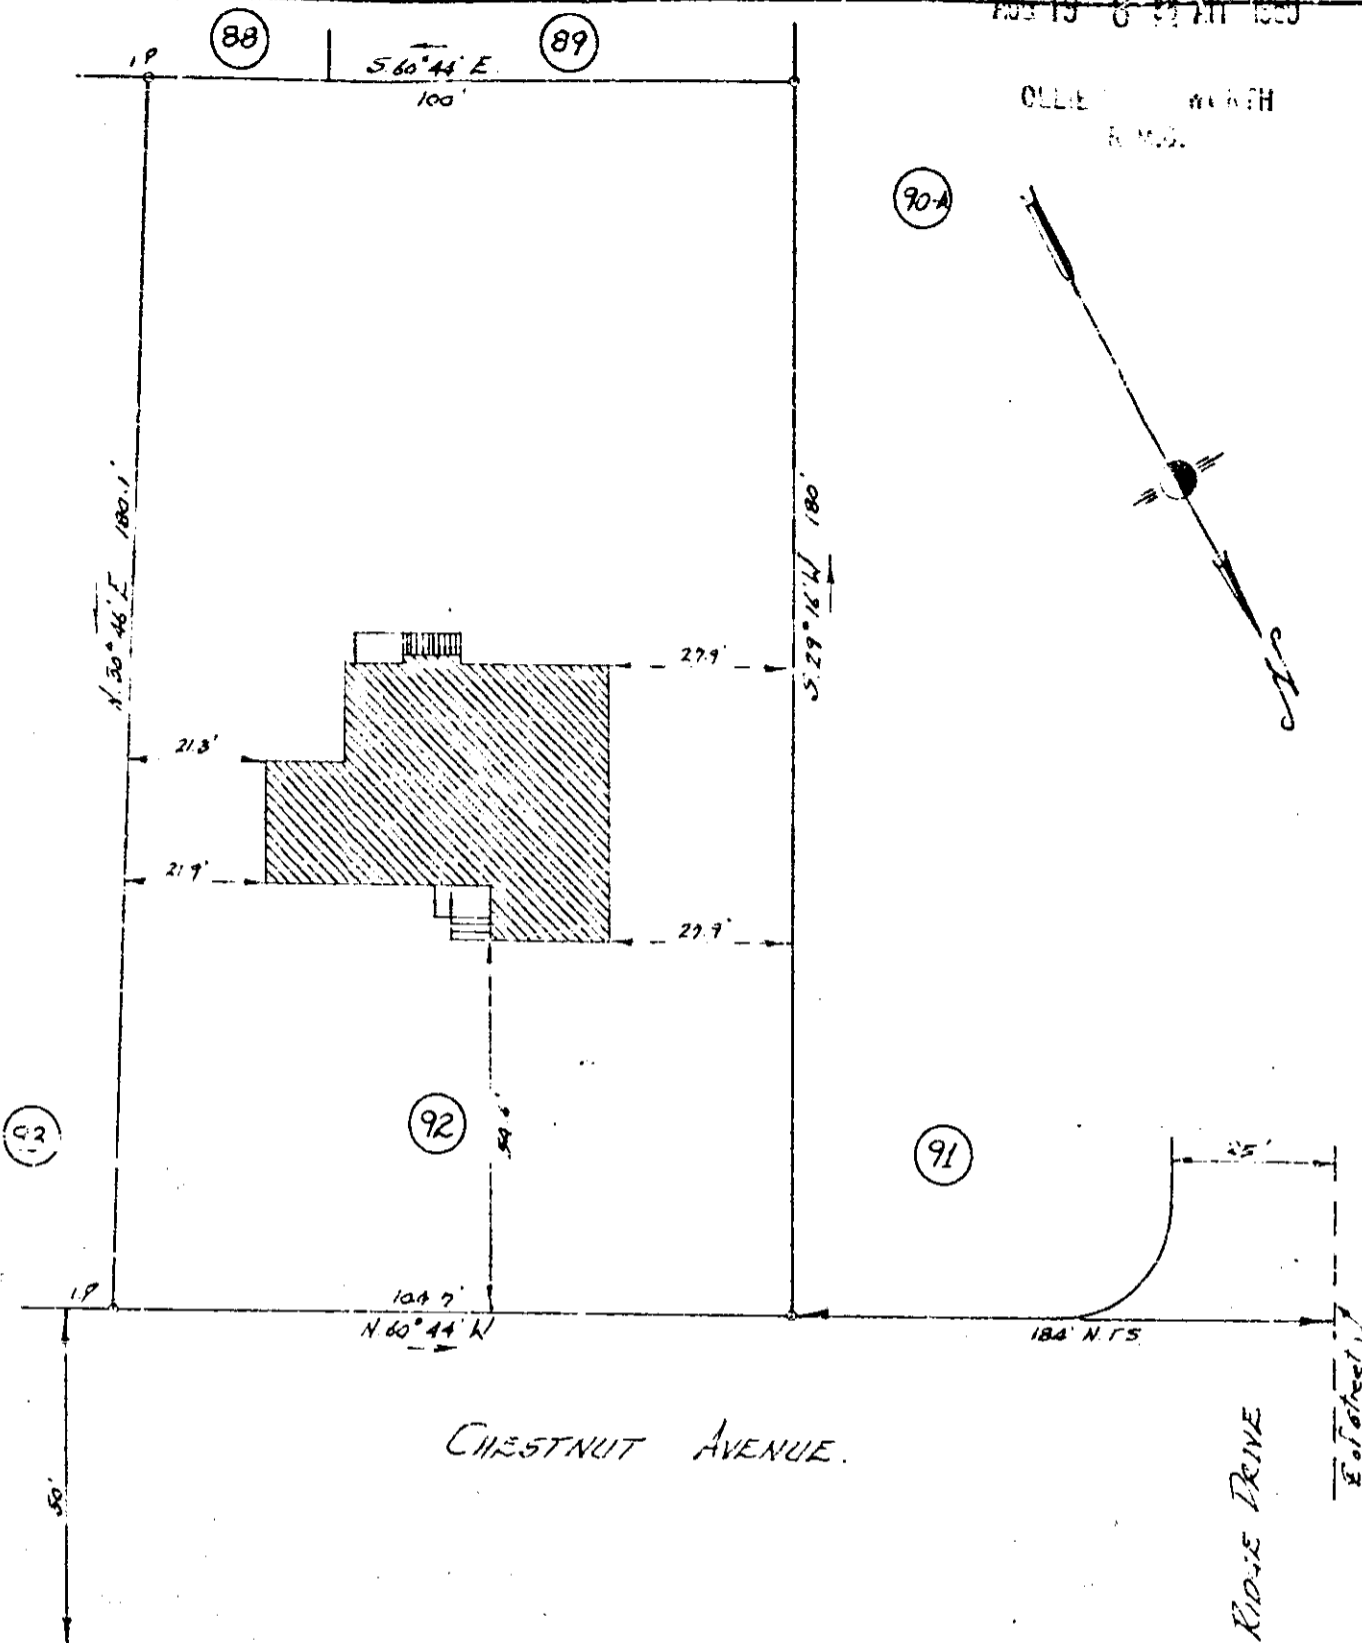

PROPERTY OF
A. B. McCONNELL ALVIN B. McCONNELL

CHICK SPRINGS TOWNSHIP GREENVILLE COUNTY,
 SOUTH CAROLINA.

SCALE: 1" = 30 FEET July 22, 1960

This is to certify that on July 21st, I surveyed the property shown on this plat, and the same is correct, being known as Lot No. 92 on Plat of Property of Burgess Hills, recorded in Plat Book "Y" at pages 96 and 97, at office of R.M.C. for Greenville County, South Carolina, and that the property lines, walls and buildings shown thereon on said lot do not encroach or project on adjacent street or property, and that no adjacent buildings or walls encroach or project on said premises.

AUG 19 1960

5605

John J. Simmons
 Registered Surveyor in South Carolina.
 #2312

5005, Plat 19, Burgess Hills, 106.0
And Return
Register of Deeds Greenville, S.C.

26-126