


770

JAN 10 1957

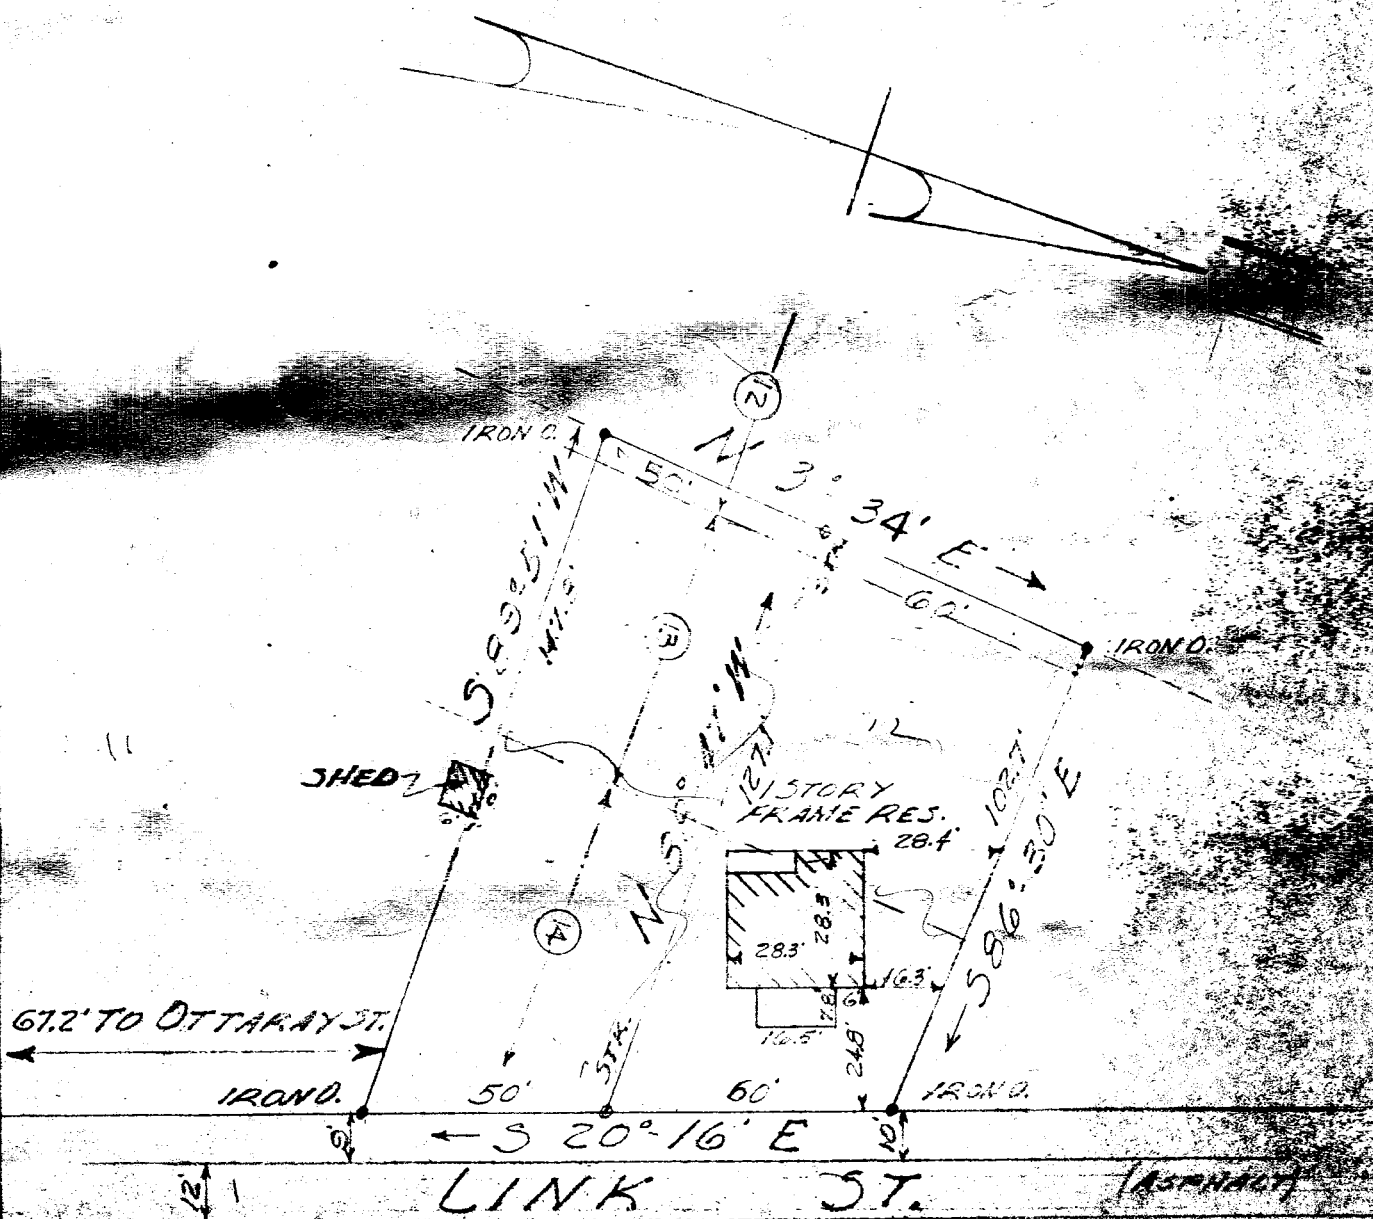

GREENVILLE, S.C.
 JUN 10 3 15 PM
 OLLIE FARNSWORTH
 R. M. C.

PROPERTY OF: ROBERT A. AMBROSE
 LOCATED NEAR THE
 CITY OF GREENVILLE, S.C.
 PICKELL & PICKELL, ENGRS.
 GREENVILLE, S.C.
 SCALE: 1" = 40' DATED: SEPT 3, 1946

I HEREBY CERTIFY THAT THE DIMENSIONS AS SHOWN ON THIS PLAT ARE CORRECT AND THERE ARE NO PROJECTIONS OR ENCROACHMENTS OTHER THAN SHOWN

Walter Pickell ENGR

770 Filed This 10 day of Jan 1957
 and Recorded in Vol. 88 Page 167 at

Ollie Farnsworth
 Register Mesne Conveyance Greenville County, S.C.

618
 and recorded
 G
 R