


# Plat Book LL, Page 163A

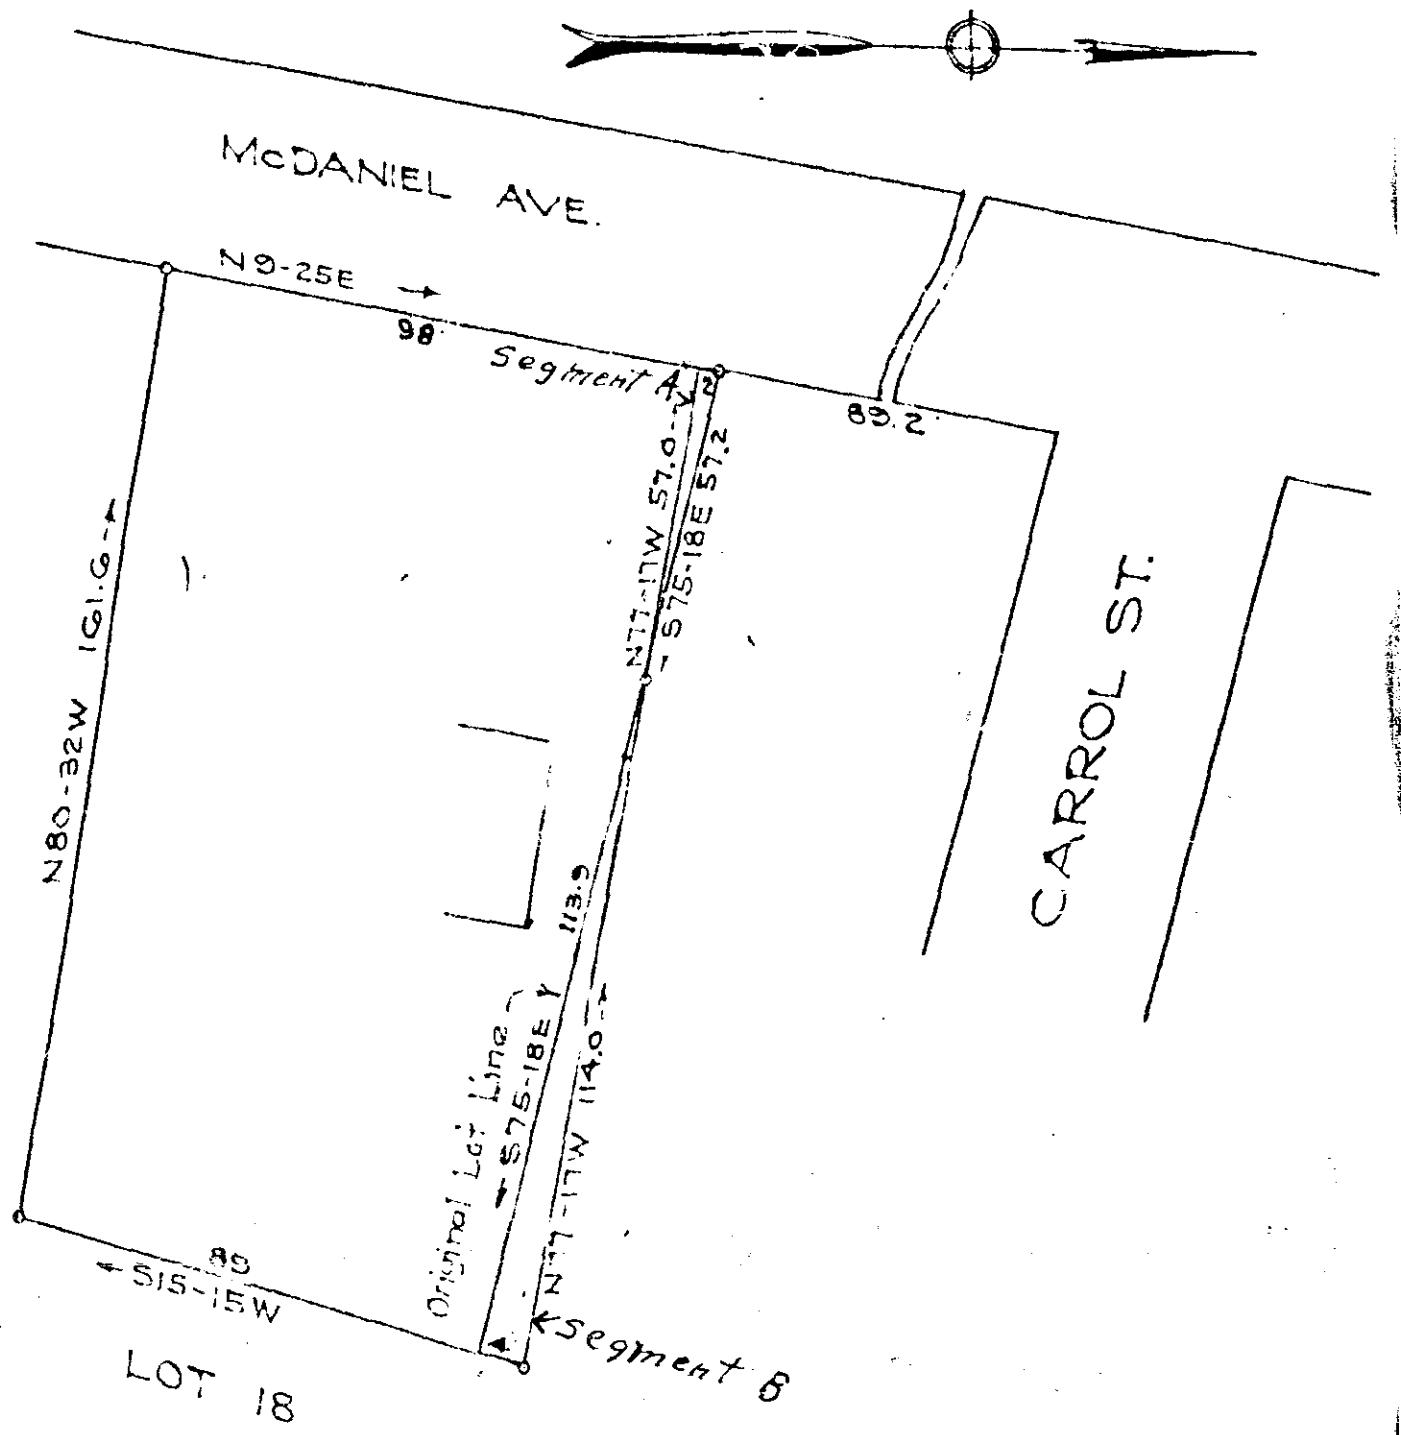

REVISION LOTS 19-20

JOHN RUTH  
GREENVILLE S. C.  
Scale 1:40 Sept. 1956

JAN 11 4 12 PM

OLIE FARNSWORTH  
R. M. C.

DALTON & NEVES

JAN 11 1957

See 30F

959

304

LL - 163

Revised Dec 1956

959 filed this 11 day of Jan 1957  
and Recorded in Vol. S, Page 163 at 4:12 P.M.

Ollie Farnsworth

Register Mesne Conveyance Greenville County, S. C.