

FILED  
GREENVILLE CO. S. C.  
SEP 30 2 52 PM 1959  
GILLIE B. NEWBIRTH  
REGISTER

ALVIN C. WHITE


10112 - Plat Title 3 Given of 1959  
 and Recorded in Vol. 111, Page 1  
 Register of Deeds Greenville County, S. C.

NOTE: IRON PINS AT ALL CORNERS

PROPERTY OF  
**GOLDEN STRIP SHOPPING CENTER INC.**  
GREENVILLE COUNTY  
MAULDIN, S.C.

SCALE 1" = 60'  
SEPT 30, 1959

This is to certify that on the 26th day of Sept. 1959, I surveyed the property shown on this plat, known as part 3, C.C. White Estates shown on plat in R.M.C. Office, Greenville County, in plat book "EE" at page 25, and also known as property, Golden Strip Shopping Center Inc. according to plat recorded in R.M.C. Office in Greenville County in plat book page ; and that the property lines, walls and buildings are as shown hereon, and that the buildings located on said lot do not encroach or project on adjacent street or property, and that no adjacent buildings or walls encroach or project on said premises.

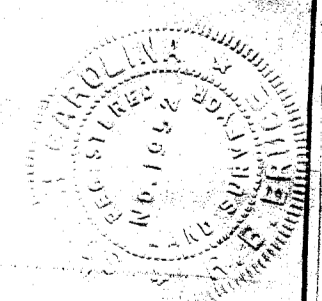

*R.B. Bruce*  
R.B. Bruce, R.L.S. No. 1952.

SURVEYED BY R.B. BRUCE R.L.S. 1952

PT. OF TRACT NO. 3 C.C. WHITE EST. PLAT BOOK EE-25

10112 SEP 30 1959  
150

mm - 131