


E. R. TAYLOR

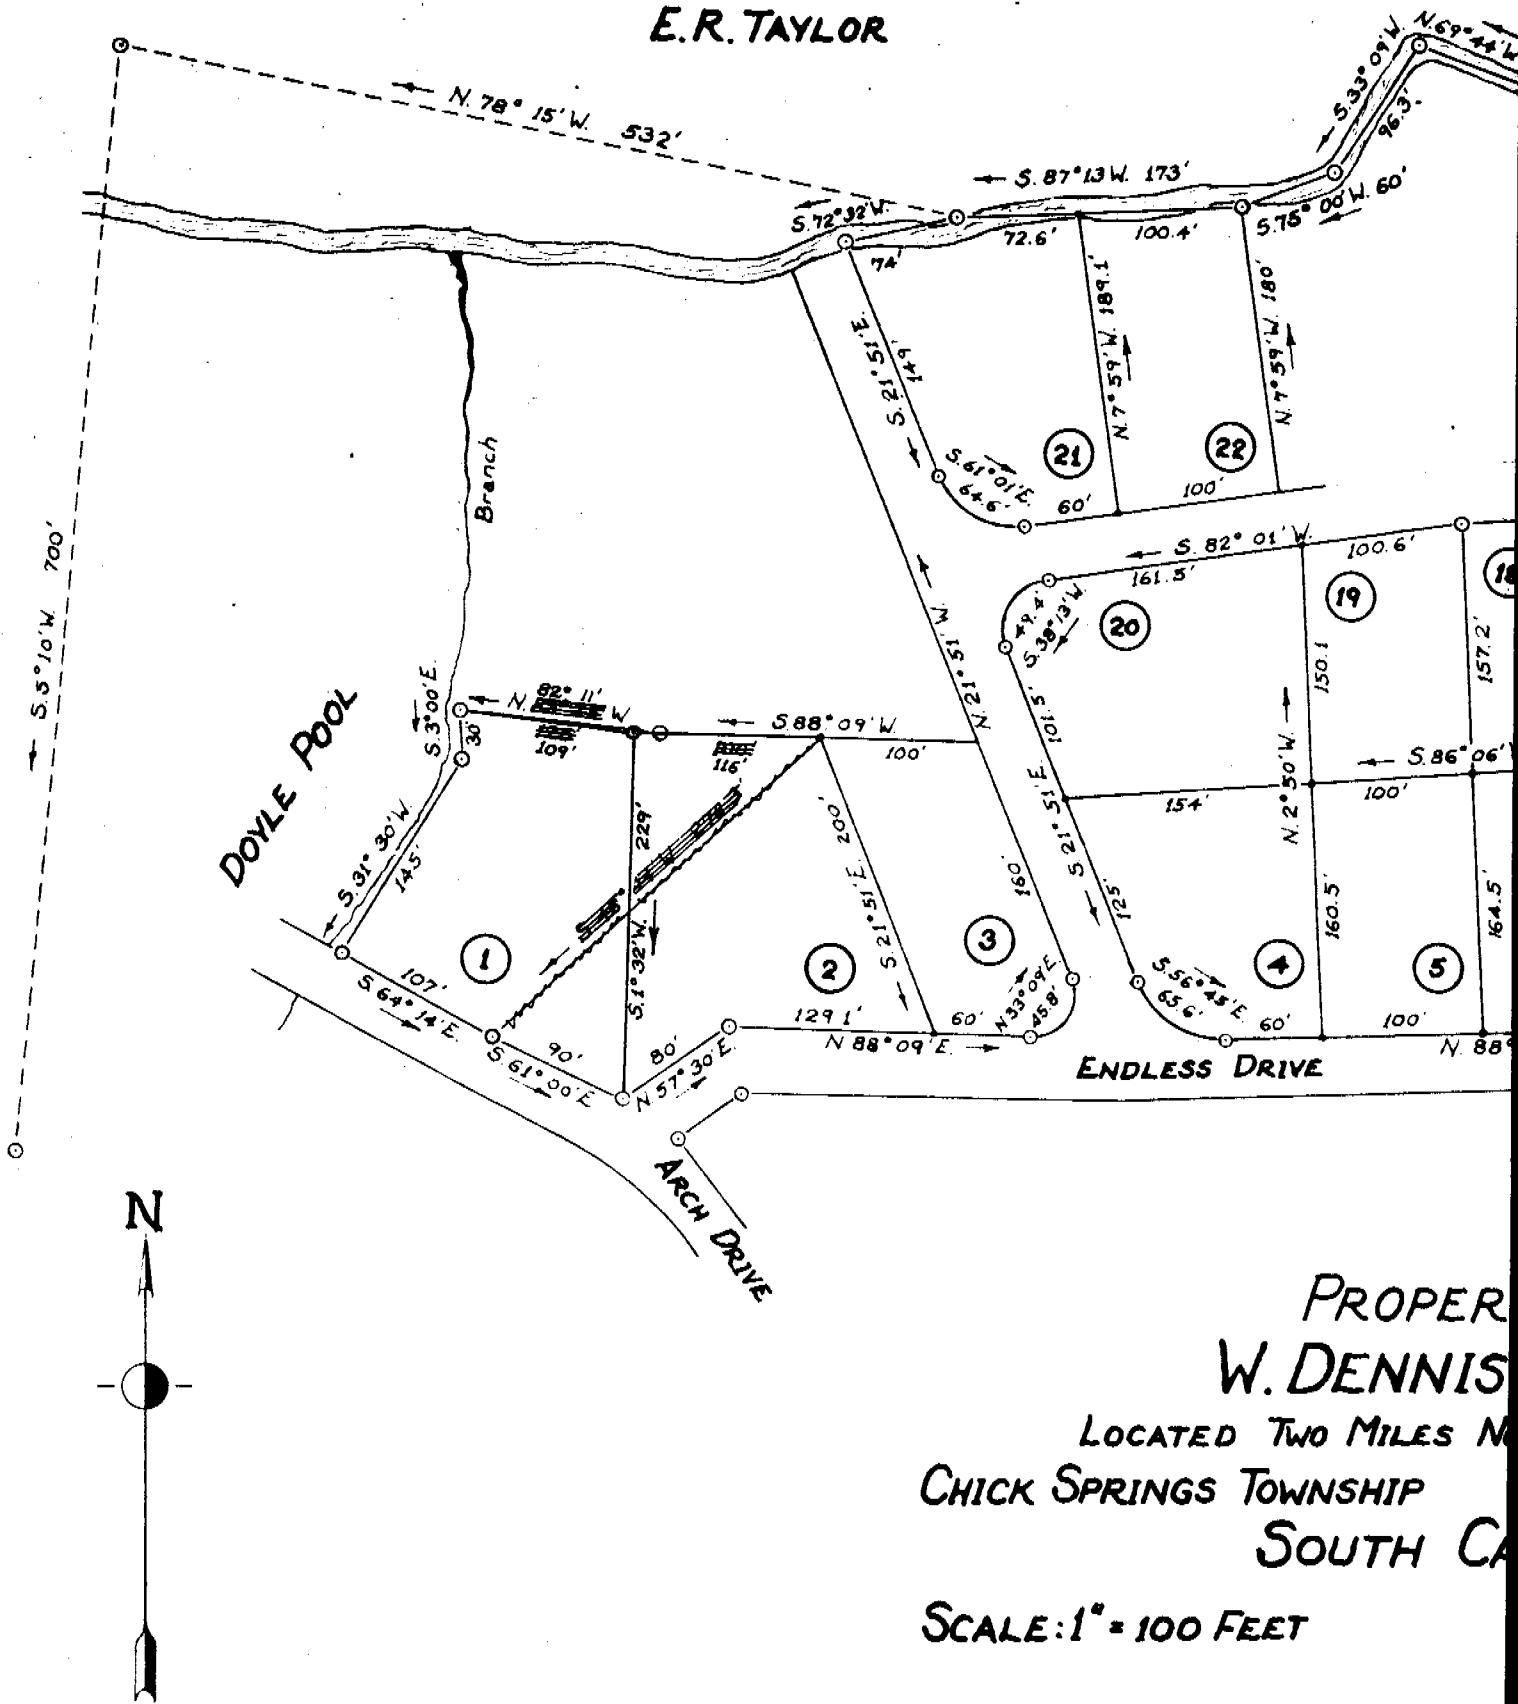

PROPER  
W. DENNIS  
LOCATED TWO MILES N  
CHICK SPRINGS TOWNSHIP  
SOUTH CA  
SCALE: 1" = 100 FEET