


Iron pipe at corners. Underground utilities location approximate.

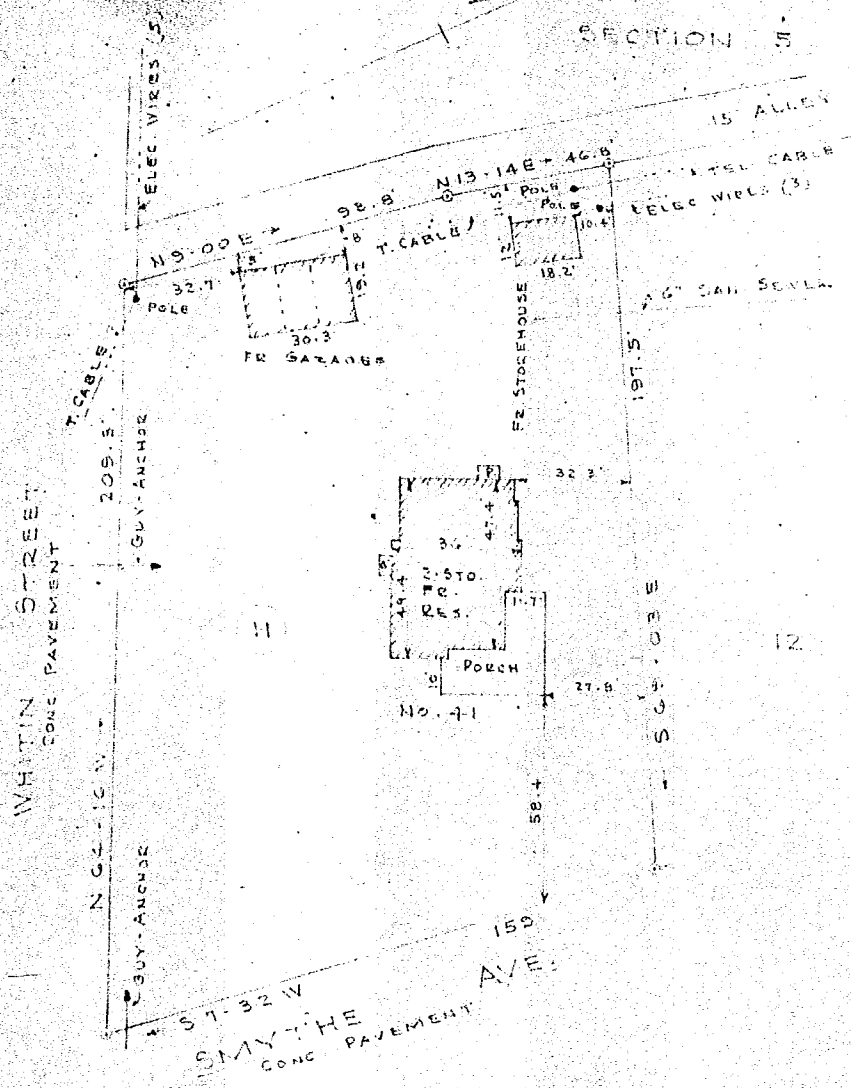

Plat Showing Property of
 DAVID C. and THELMA B. LEE
 Located in Dunbar Mill Village, Greenville County
 Near Greenville, S. C.
 Scale: 1" = 50' Dated August 18, 1952

Pickell & Pickell - Engineers
 Greenville, S. C.

I hereby certify that the measurements as shown on this
 plat are correct and there are no projections or encroach-
 ments other than shown.

JUN 28 1958

193

1.00 - picture

Recorded June 28, 1958 at
 9:14 A. M. # 193

John Pickell R.L.S.
 OLIVER F. PICKELL
 JUN 28 9 14 AM 1958
 GREENVILLE CO. S. C.