Plat Book OO, Page 427

LEHMAN ADWELL MOSELEY, JR.
ATTORNEY AT LAW
TRAVELERS REST, S. C.

N.B No. 136

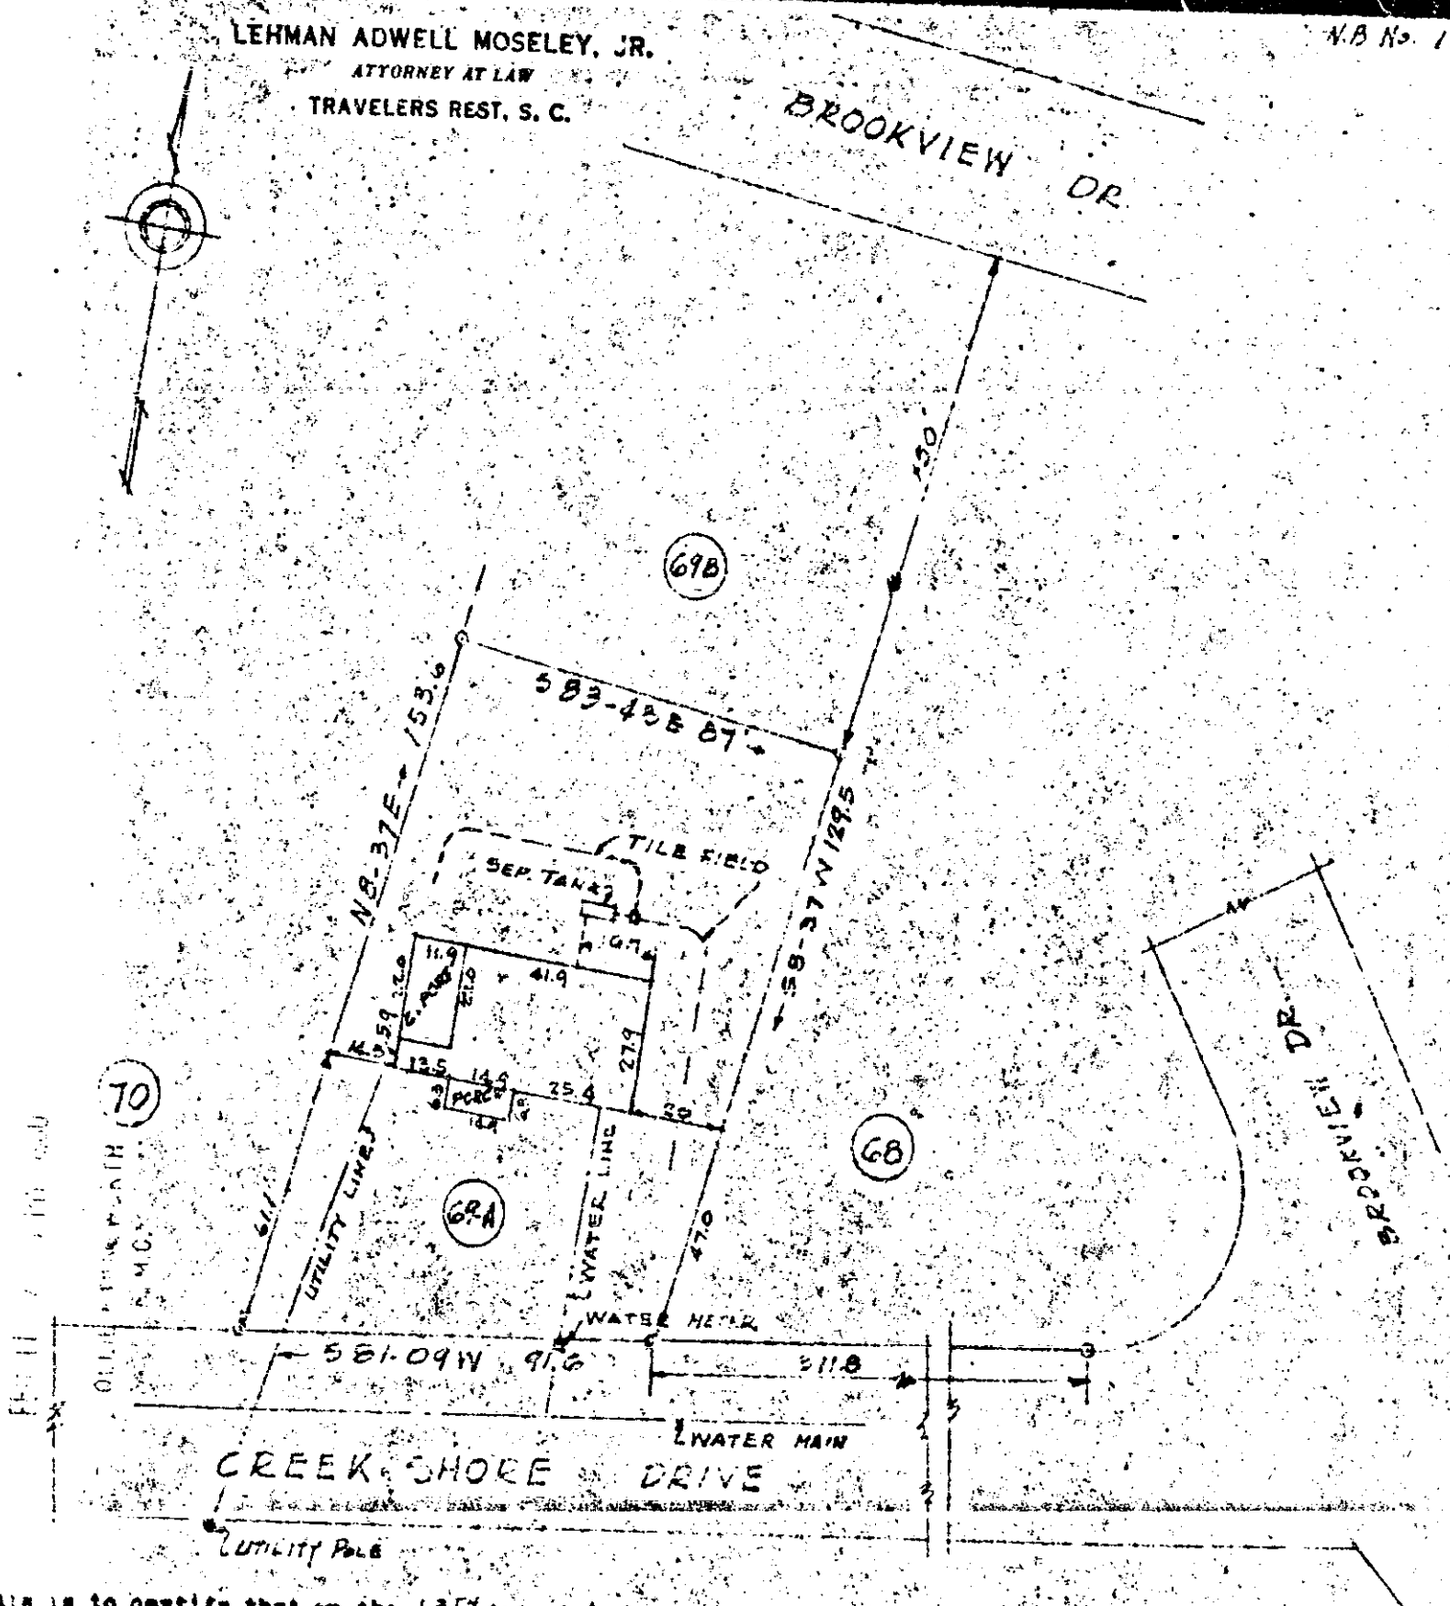

This is to certify that on the 13th day of Aug. 1959 I surveyed the property shown on this plat, being Lot No. 69A Southern Part of Original Lot No. 29 (Fresh Pleadon Farms), recorded in Plat Book M page 27 of the R.M.C. Office for Greenville County, S. C., and that the property lines, walls and buildings are as shown hereon; that the buildings located on said lot do not encroach or project on adjacent streets or property; and that no adjacent buildings or walls encroach or project on said premises, and that no utility lines cross this property.

Reg. Engineer No. 1144 S.C.

PROPERTY OF
ELWOOD L. & HELEN R. JOHNSON
NEAR
GRENVILLE, S. C.
SCALE 1" = 40' AUG. 14, 1959

Recorded February 11, 1960 at 4:05 P. M
#22637

P.B. "OO"-427 FEB 11 1960

JONES & SUTHERLAND ENGINEERS