


REMAINDER OF LOT #9.

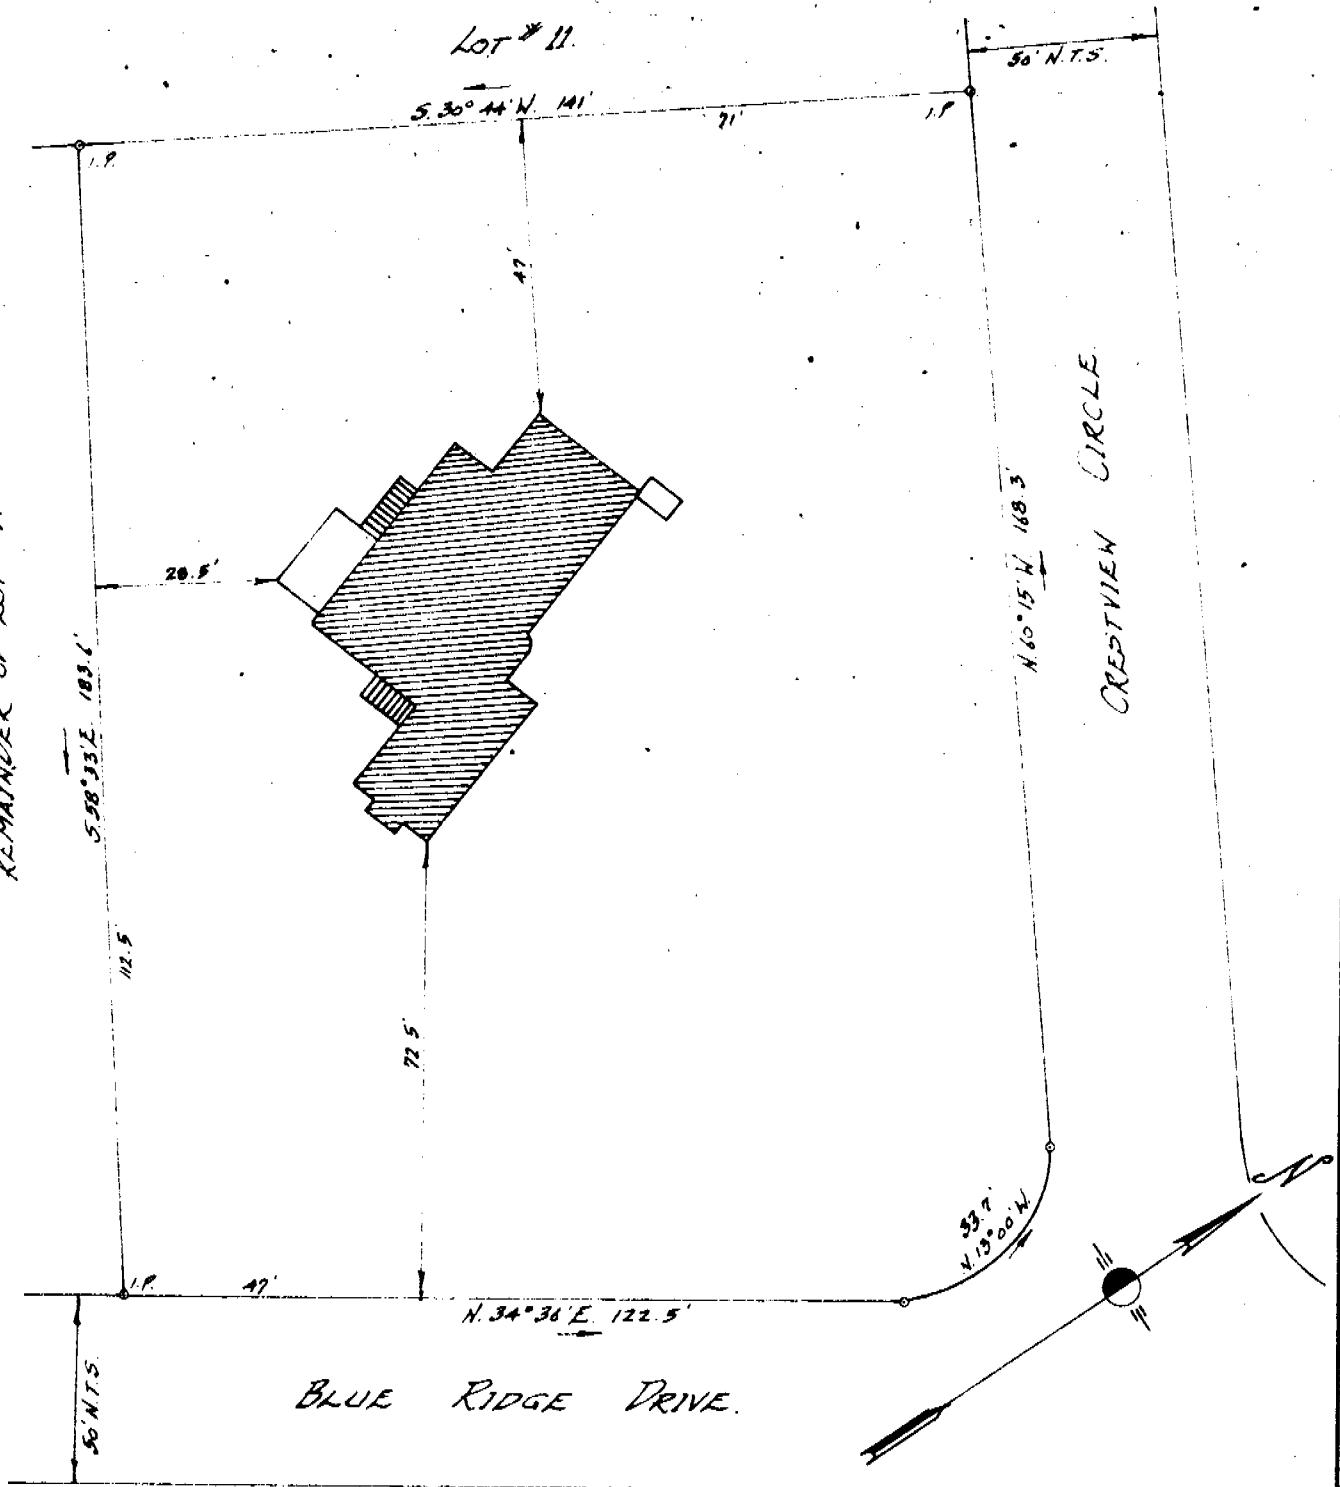

PROPERTY OF  
WILLIAM G. GRANT.

Located in Green,  
CHICK SPRINGS TOWNSHIP GREENVILLE COUNTY.  
SOUTH CAROLINA.

SCALE: 1" = 30 FEET.

MAY 19 1960.

This is to certify that on May 17th 1960 I surveyed the property shown on this plat, and the same is correct, being known as all or lot No. 10 and a strip off of lot No. 9 on side of property of FULMER HALL, recorded in Plat Book "B" at pages 66-67, office of R. L. C. for Greenville County, South Carolina, and that the property lines, walls and building thereon do not encroach or project on adjacent's property or property, and that no adjacent buildings or walls encroach or project on said premises.

OLIE J. HODGES

MAY 18 2 1960 P.M.

MAY 18 1960

00-461 Recorded May 18, 1960 at 2:09 P. M. #31574

10 Picture