


Recorded at Office 19, 1966 #10504

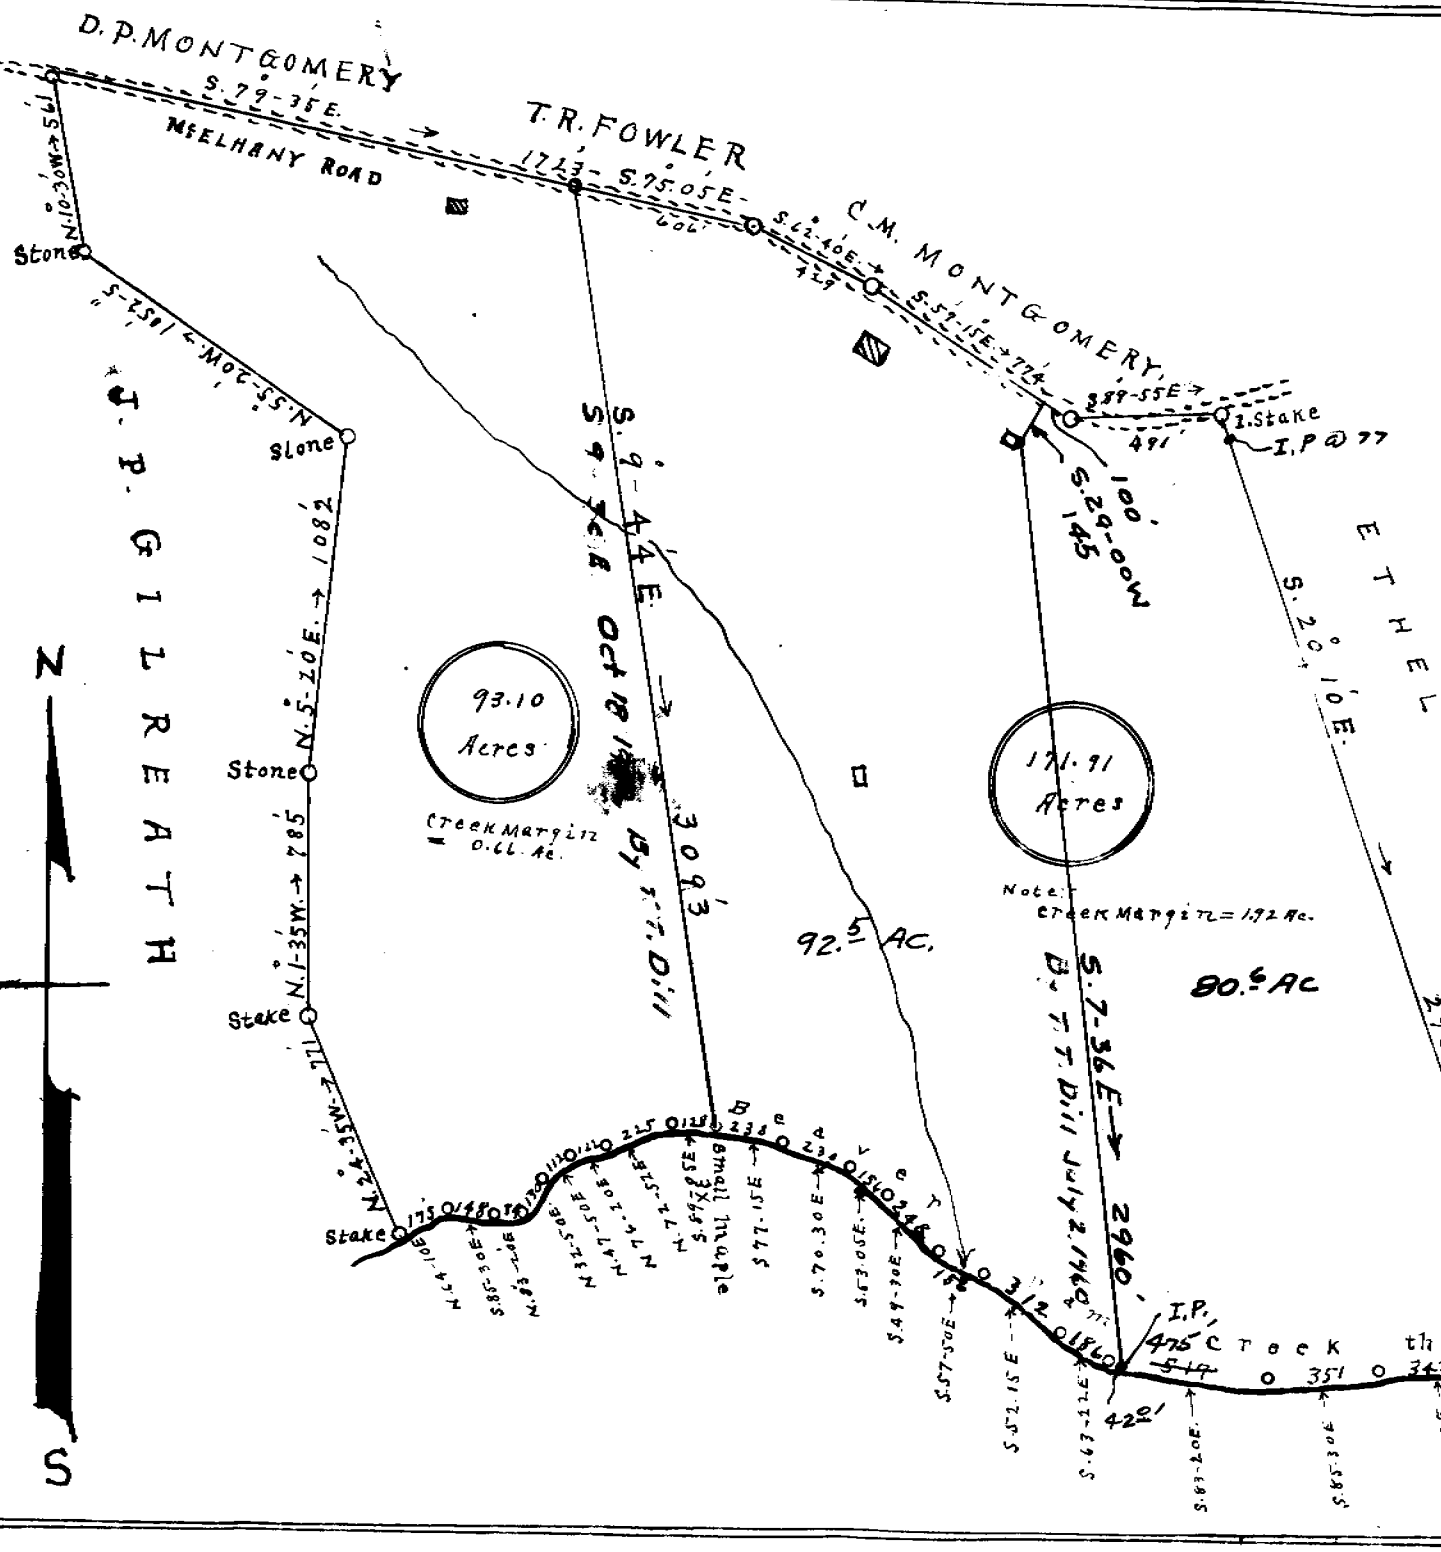

PROPERTY OF  
**H.J. GILREATH**  
 LOCATED IN  
 School District No 11-E  
 NEAR  
**JACKSON GROVE CHURCH.**  
**GREENVILLE CO. S.C.**

surveyed  
 JAN. 20-21, 1941.  
 J.H. Atkins, Surveyor  
 Campobello, S.C. - R-2

Scale: - 1-in = 500 FL.

93.10  
 Acres

171.91  
 Acres


92.5 AC.

80.6 AC

Note: Creek Margin = 172 Ac.

OCT 19 1960

10504

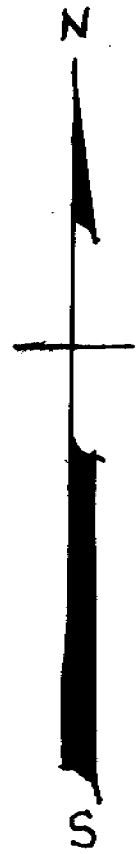

J. P. GILREATH

Stone  
 1082  
 N. 5-20E  
 785  
 N. 1-35W  
 Stake  
 711  
 N. 15-15E

Stake  
 175  
 180  
