

Plat Book PP, Page 65 A


GREENVILLE CO., S. C.

42228

FEB 21 11 20 AM 1958

R. M. C.

FEB 21 1958

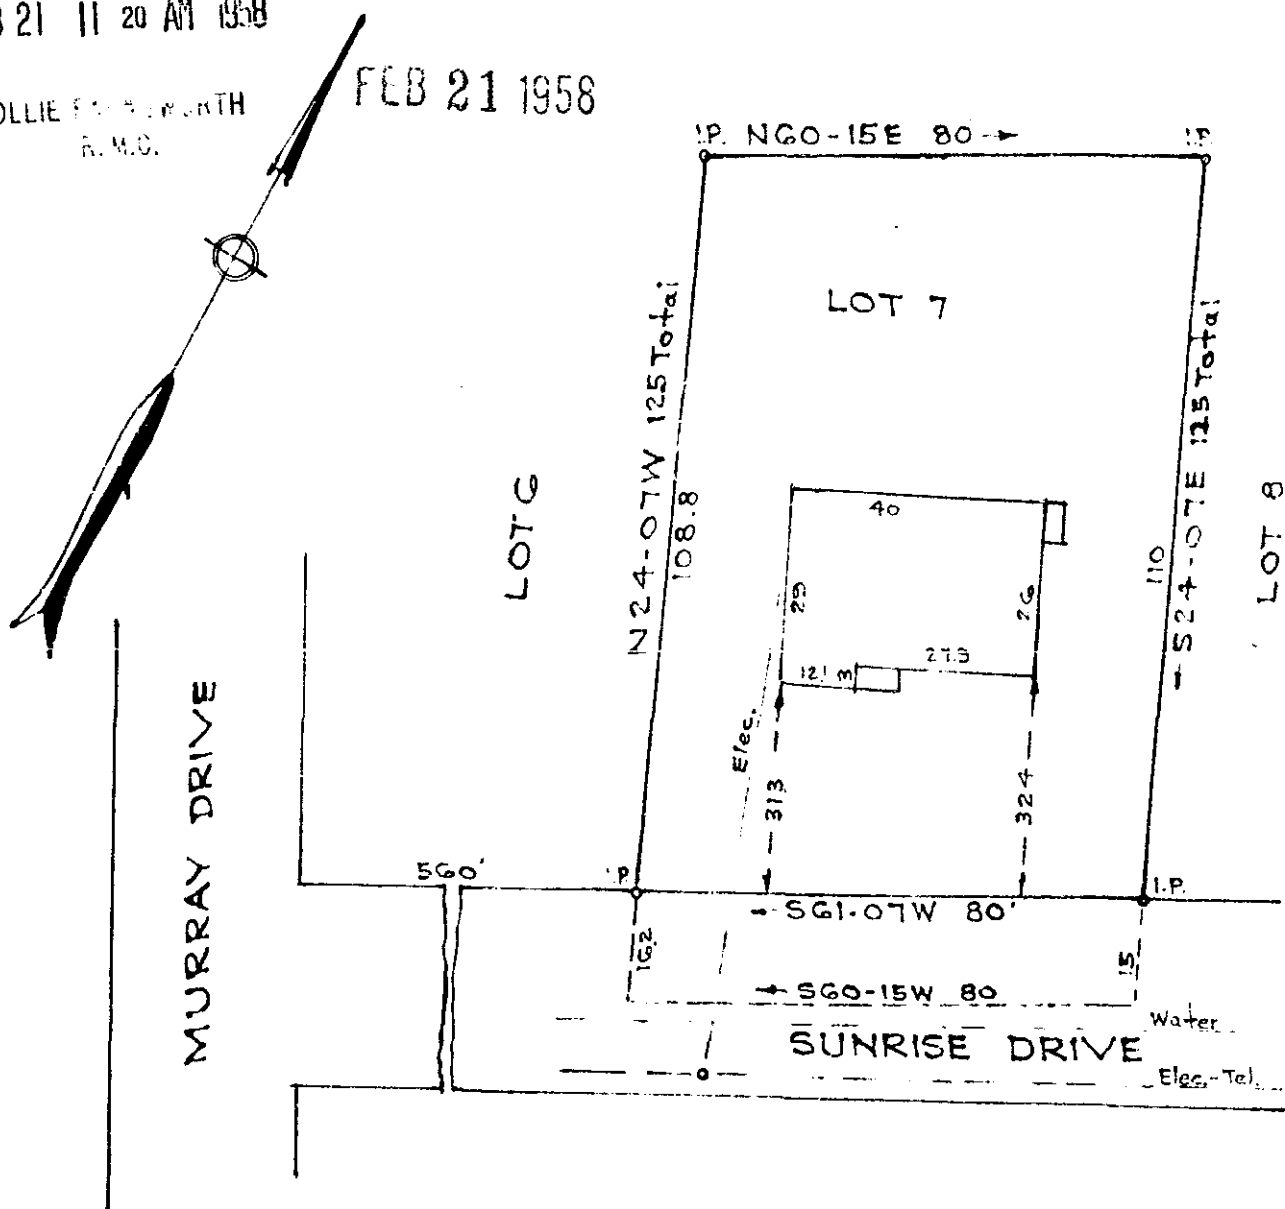

PROPERTY OF
 WILLIAM M. BURKHALTER
 MAULDIN S. C.
 Scale 1"=30' Feb. 1958

This is to certify that on the 14th day of February, 1958, I surveyed the property shown on this plat; being known as Lot 7 on plat of William M. Burkhalter, Recorded in Plat Book PP page 65, Office of R. M. C. Greenville Co., S. C.; and that the property lines, walls and buildings are as shown hereon; that the buildings located on said lot do not encroach or project on adjacent streets or property; and that no adjacent buildings or walls encroach or project on said premises; and that no utility lines cross this property except as shown hereon.

H. W. Dalton
 Registered.

322 50'
 33-63'

318

4775 Filed This 21 day of Feb. 1958
 and Recorded in Vol. PP Page 65 of
 Register Aisne Conveyance Greenville County, S. C.