


#16917 Filed This 6 day of Jan. 1958
 And Recorded in P.P. 150 M.
 O.D. Edwards
 Register of Deeds Greenville County, S.C.

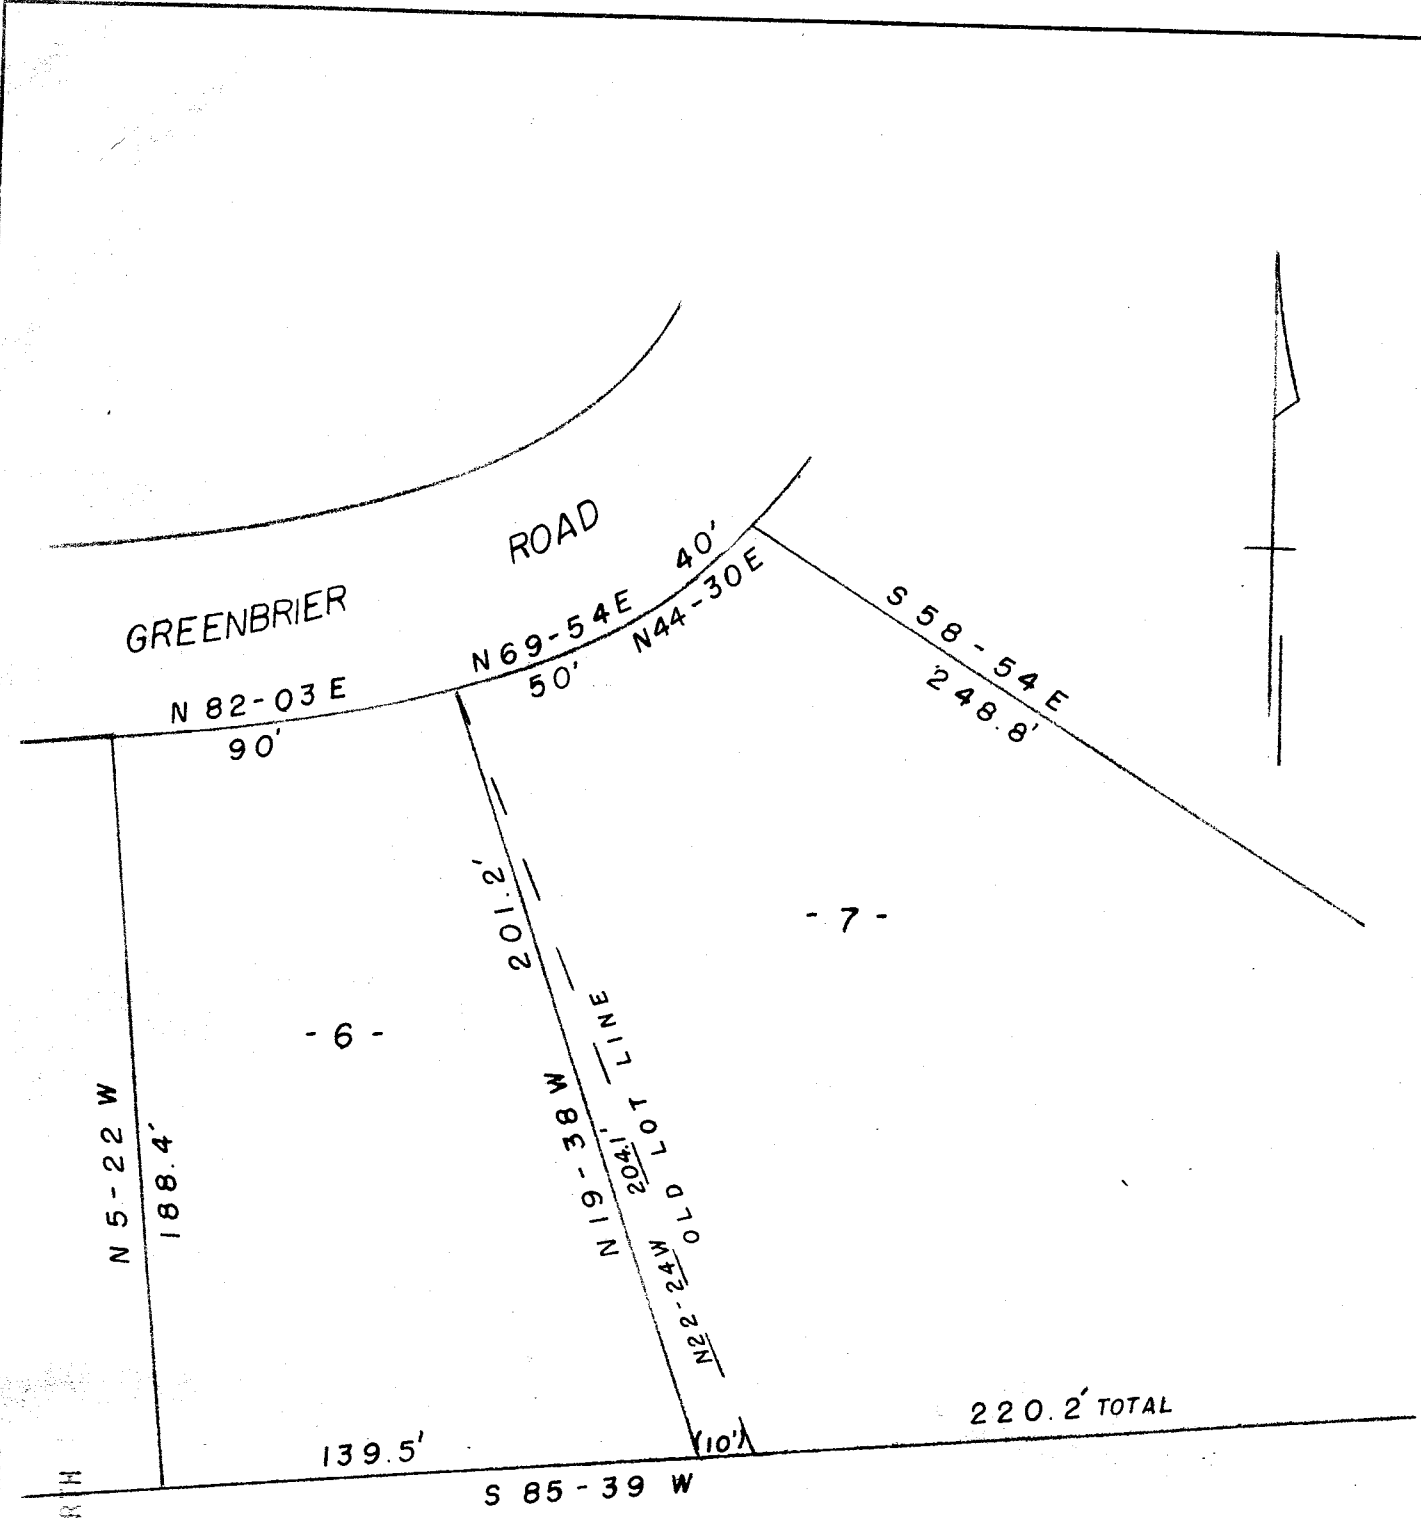

JAN 6 3 01 PM 1959

OLLIE FAIRBANKS WORTH
 R.M.O.

SURVEY OF LOTS
 6 & 7
 LAKE FOREST HEIGHTS
 SECTION TWO

JAN 6 1959

16917



PP - 150

PIEDMONT ENGINEERING SERVICE
 GREENVILLE, S. C.