
Plat Book PP, Page 159A

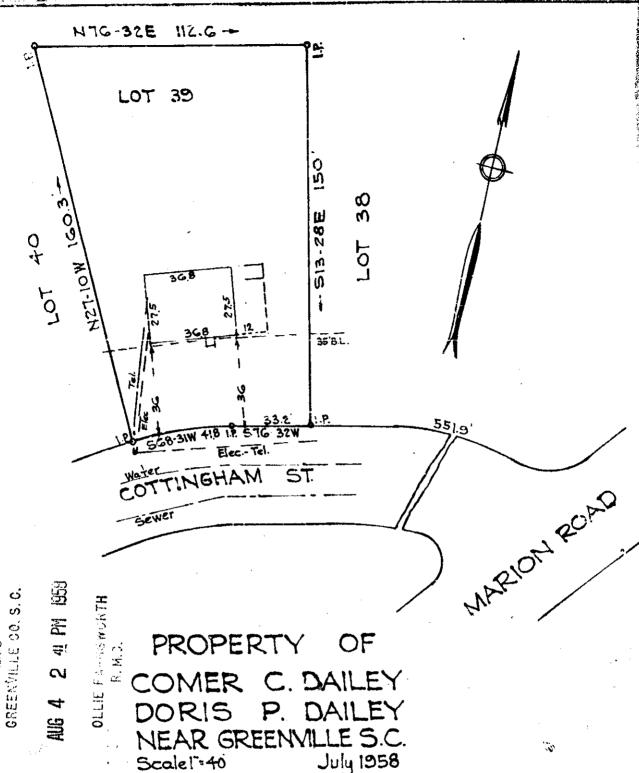

This is to certify that on the Sath day of July, 1958. I surveyed the property shown on this plat; being known as Lot 39 on plat of Monaghan Subdivision, Recorded in Flat Book GG pages 86-87. Office of R. M. C. Greenville Co., S. C.; and that the property lines, walls and buildings are as shown hereon; that the buildings located on said lot do not encroach or project on adjacent streets or property; and that no adjacent buildings or walls encroach or project on said premises; and that no utility lines cross this property except as shown hereon.

AUG 4 1958

Registered.

3399

321 504 - PP-159