


FRANK HOWARD

J.V. SMITH ESTATE

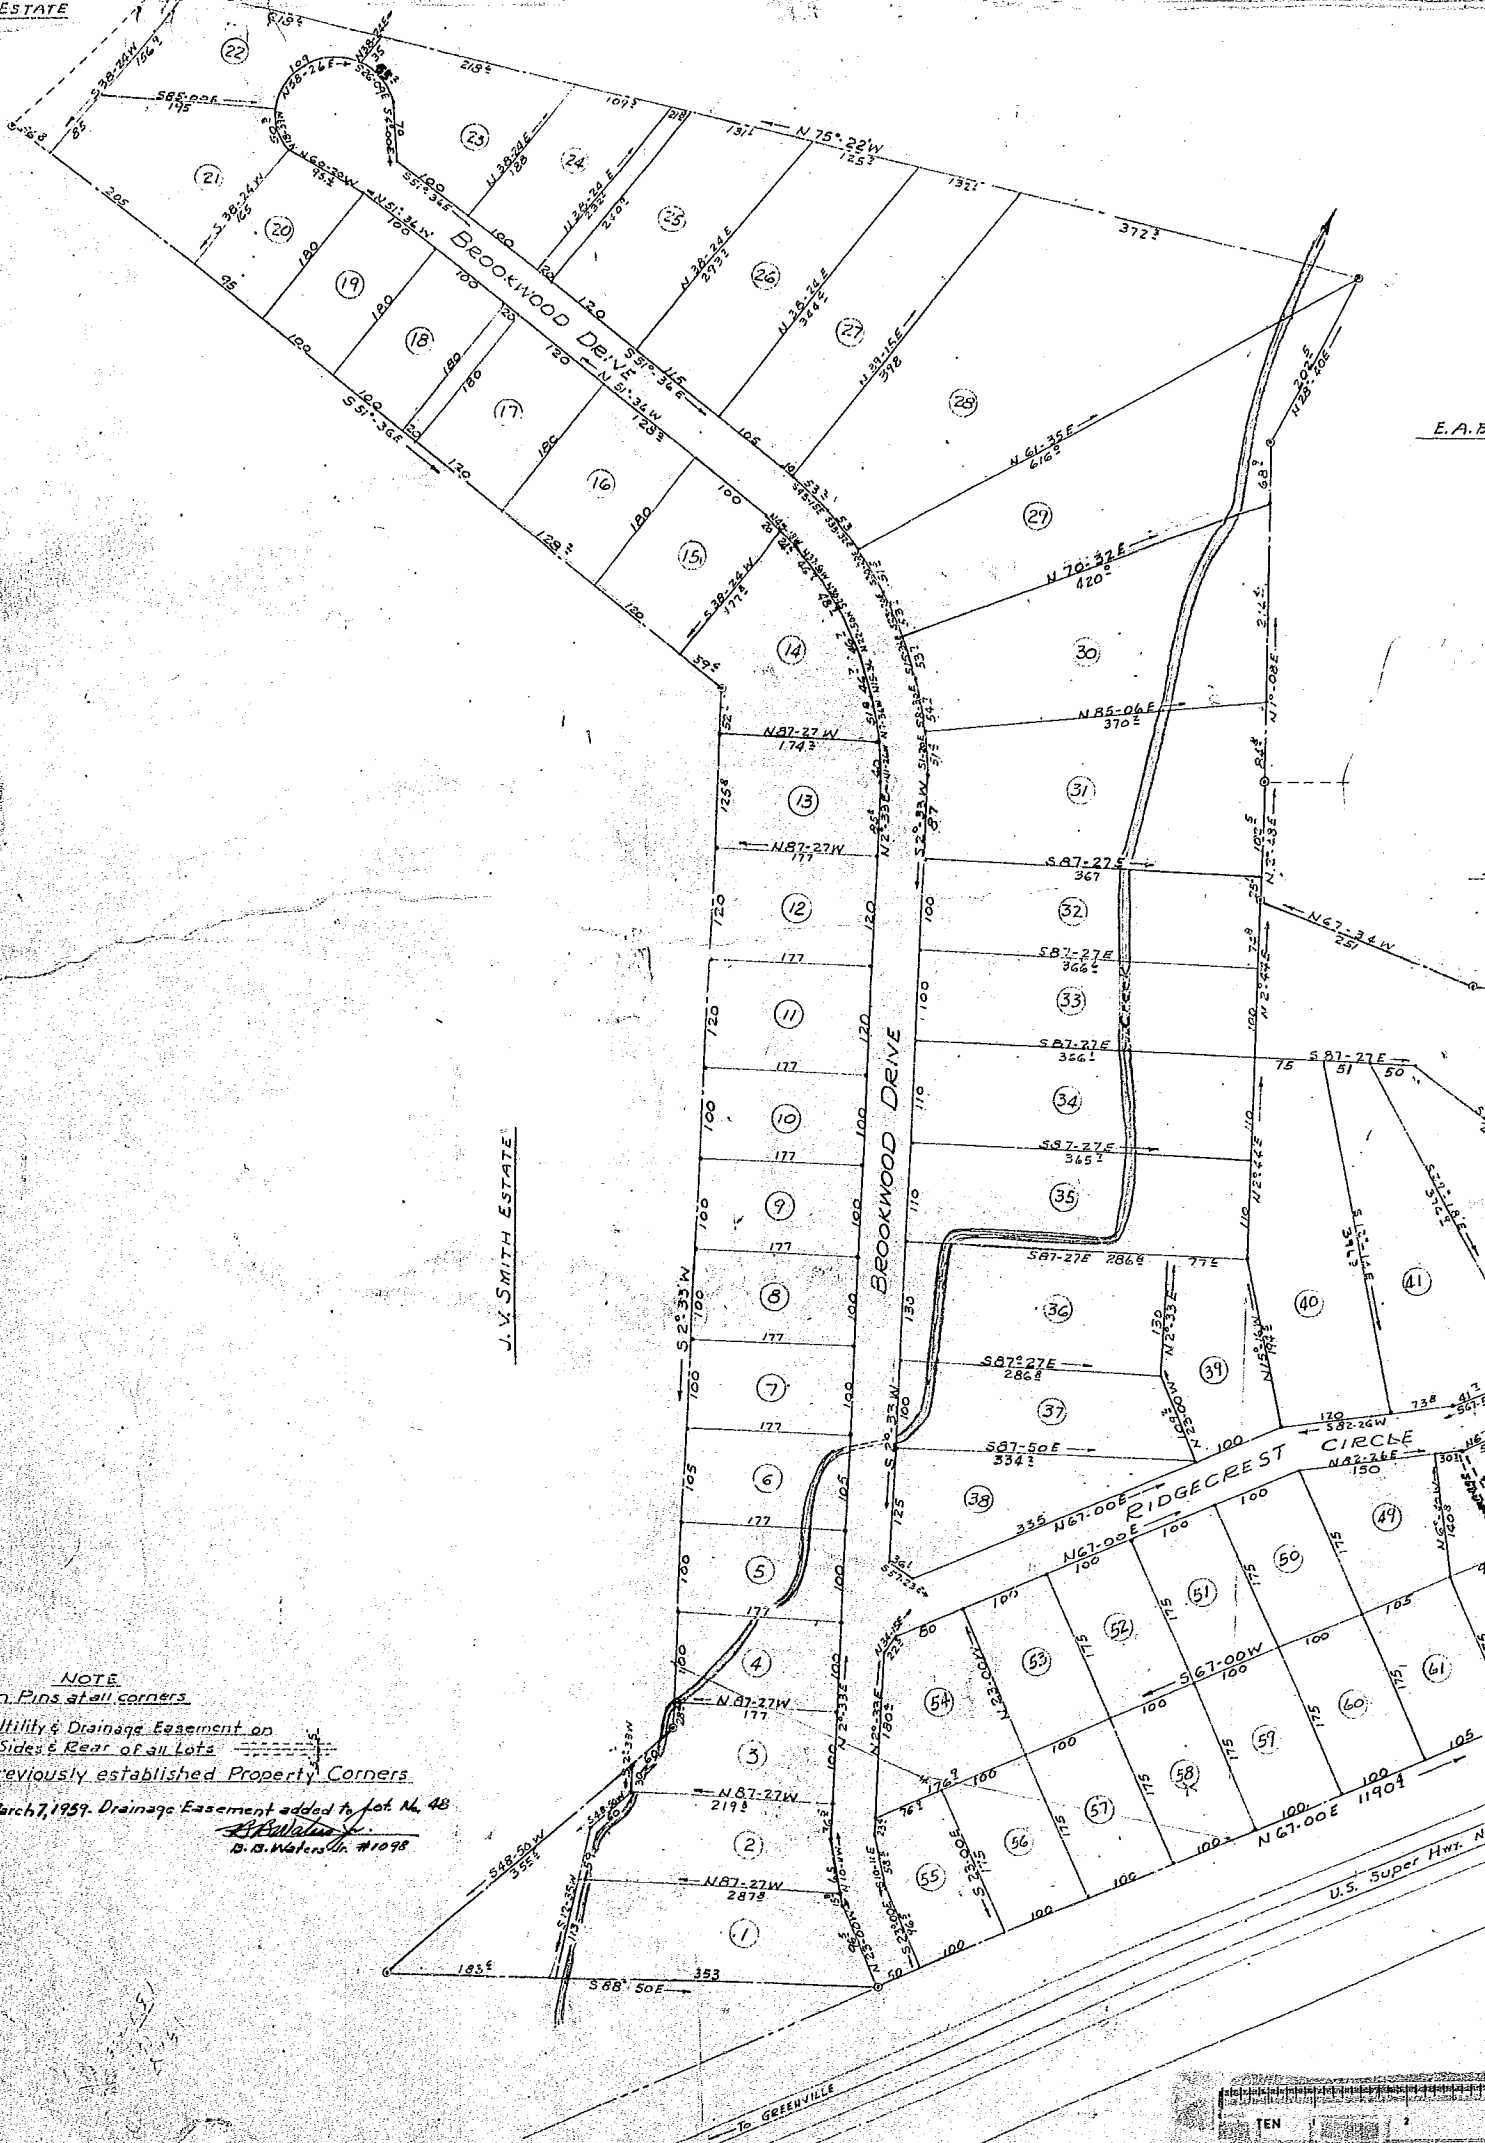


J.V. SMITH ESTATE

E.A. B...

NOTE
 Iron Pins at all corners
 5' Utility & Drainage Easement on
 Sides & Rear of all Lots
 o Previously established Property Corners

March 7, 1959. Drainage Easement added to lot No. 48
 B. D. Walters, Jr. #1098

U.S. Super Hwt. No.

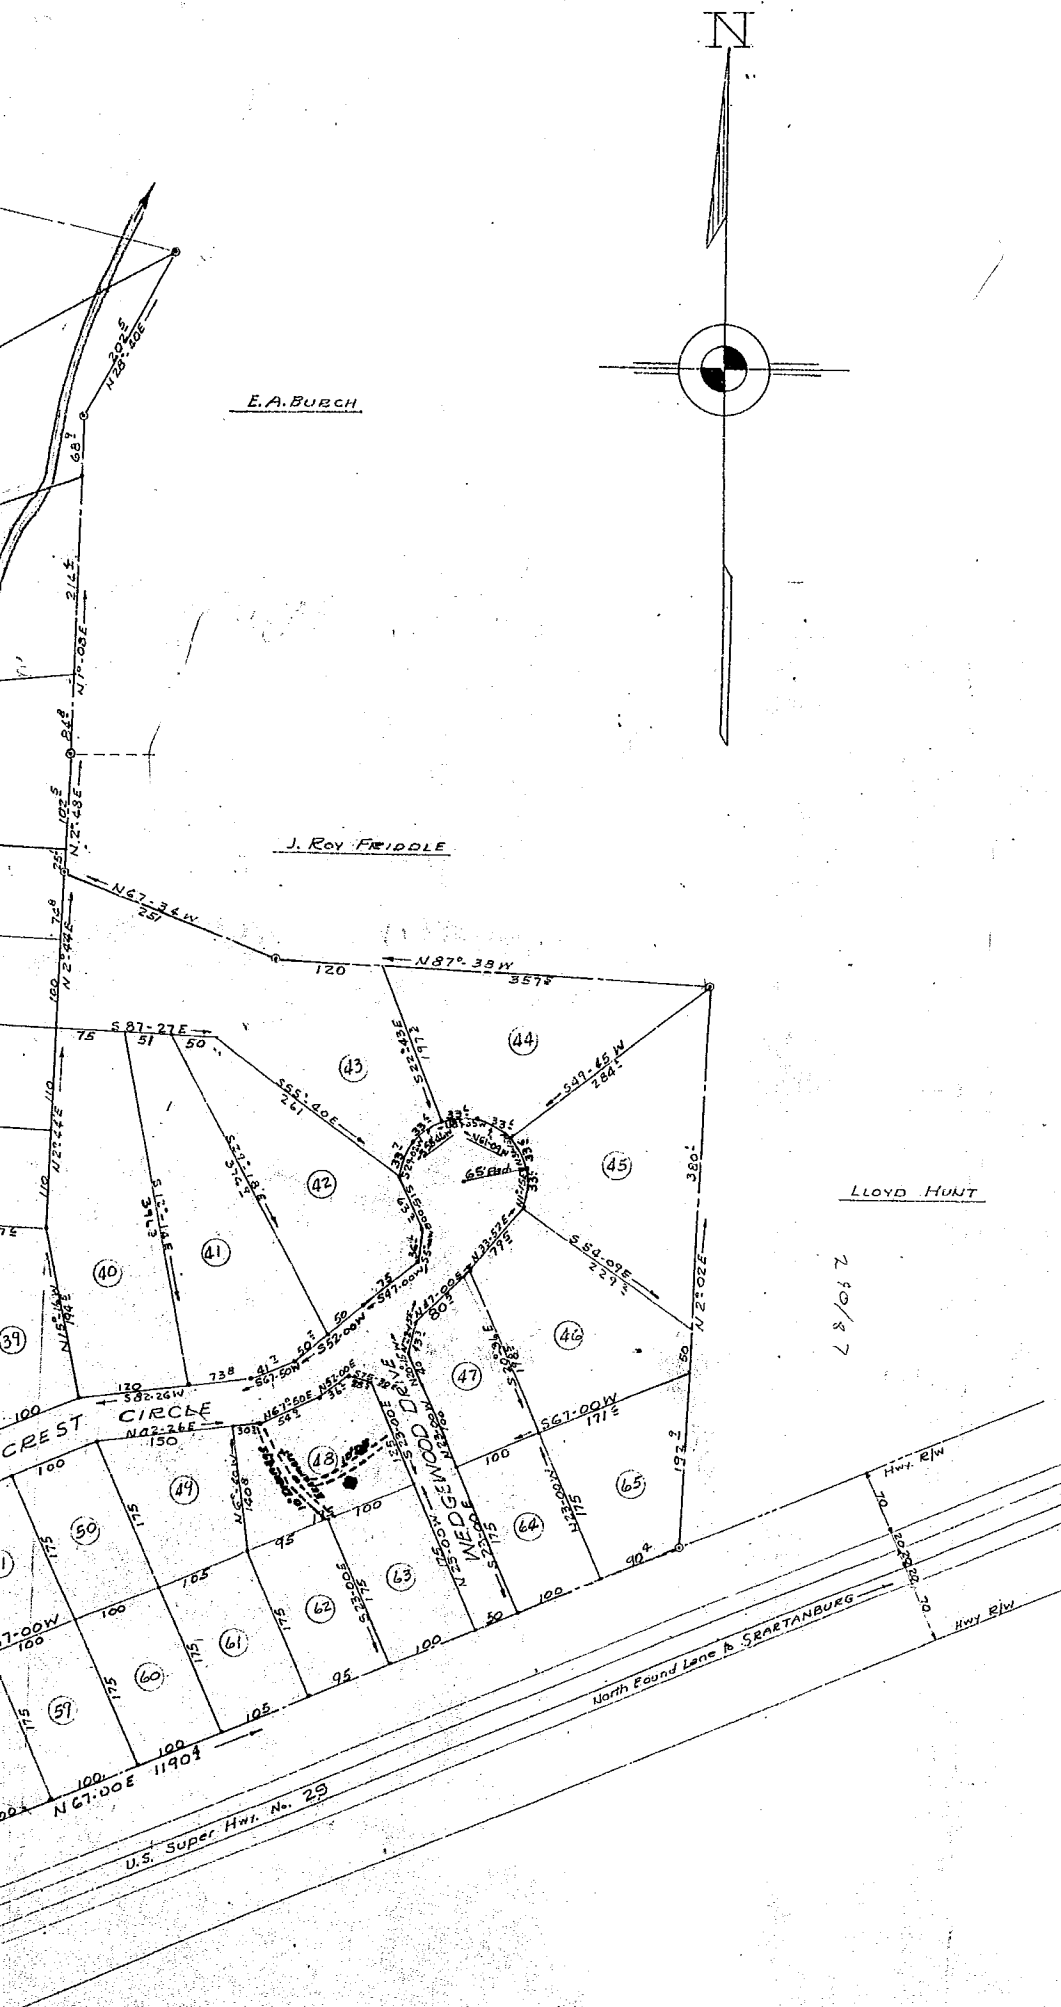

10781
 24
 21
 58
 C. W. Sauer
 Surveyor
 Greenville, S.C.

PLAT OF
BROOKWOOD
GREER, S.C.

Scale 1"=100' Dated Oct. 14, 1958
 Surveyed by: B.B. Waters Jr. 11:10:98

OCT 24 2 59 PM 1958
 GREENVILLE, S.C.
 FILED

OCT 24 1958
 10781

See 2nd
 99-21