

# FINAL PLAT COPELAND DALE


PROPERTY OF  
 DR. F. L. PLOWDEN  
 GREENVILLE, S.C.  
 SCALE 1" = 50' JUNE 1959

MARY FRANCES G. PLOWDEN

FILED  
 JUL 21 1959 2:00  
 REC'D  
 JUL 21 3 15 PM 1959  
 GREENVILLE, S.C.  
 20-89

CERTIFICATE OF SURVEY	CERTIFICATE OF OWNER
I HEREBY CERTIFY THAT THIS IS AN ACCURATE MAP OF AN ACTUAL SURVEY COMPLETED BY ME IN JUNE 1959. [Signature] R.S. 101, 135-D, S.C. ENGINEER NO. 1144	I HEREBY CERTIFY THAT I AM THE OWNER OF PROPERTY SHOWN ON THIS MAP AND DO APPROVE OF THE SUBDIVISION THEREOF AS SHOWN. [Signature] ADDRESS: 124 GREENACRE ROAD, GREENVILLE, S.C. DATE - JUNE 1959

NOTE:  
 CHANGES MADE ON STREET NAMES DEC. 22, 1959 FROM ORIGINAL PLAT. APPROVED BY PLANNING & ZONING DEPT. CITY OF GREENVILLE, S.C.  
 [Signature]

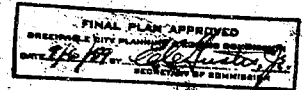

20-89 Filed This 21 day of July 1959  
 and Recorded in Vol. 200 Page 1144  
 Registrar Neane Conroyance Greenville County, S.C.

