


124

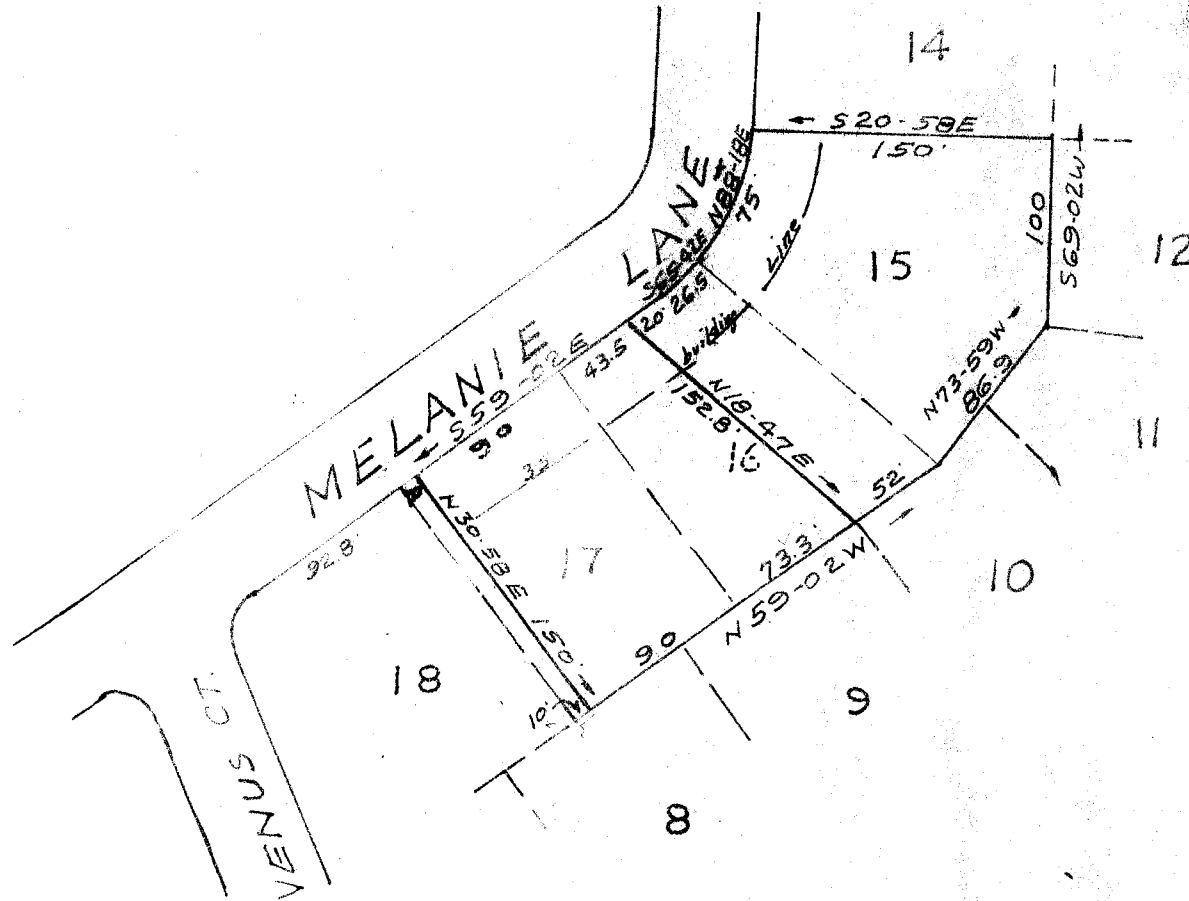

FILED  
 GREENVILLE CO. S.C.  
 OCT 31 10 45 AM 1967  
 OLLIE FANNINGHORTH  
 R.M.C.

REVISION - LOTS 15, 16, 17  
 DELLVISTA HEIGHTS  
 NEAR GREENVILLE S.C.  
 SCALE 1"=100' MAR. 20, 1967

504 OCT 31 1967

RR-124 12671

C.O. Riddell 1347

#12671 Filed This 31 day of Oct. 1967  
 And Recorded in Vol. RR Page 124 at 10:45 AM  
 Ollie Fanninghorth  
 Register Mesne Surveyor Greenville County, S. C.