


OAK CREST SUBDIVISION

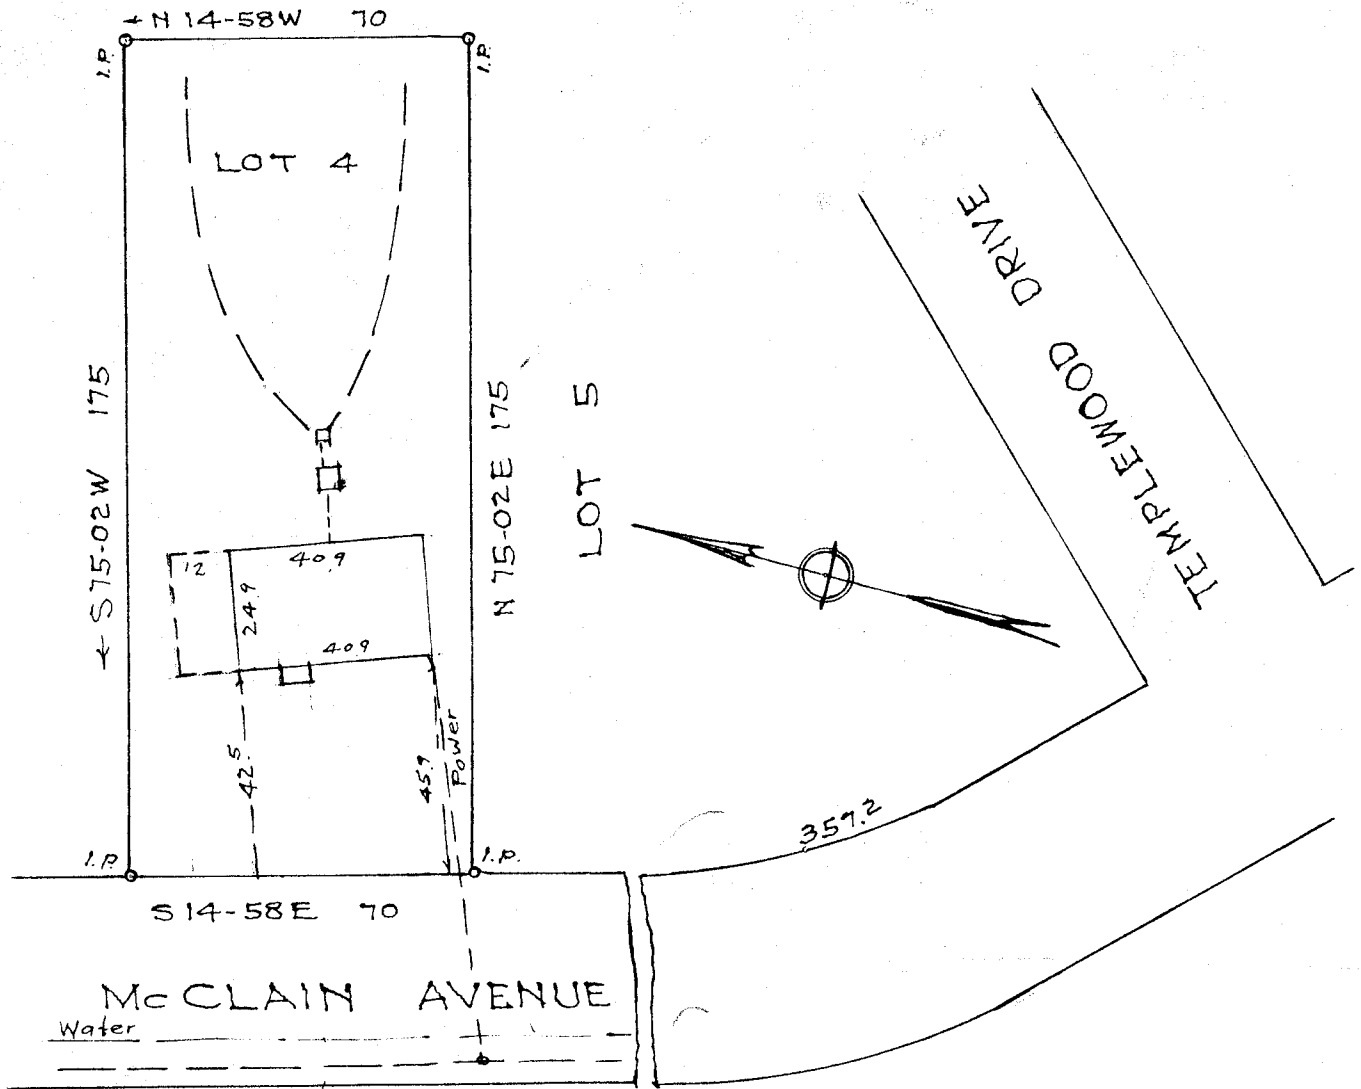

PROPERTY OF
 JACK O. CAMPBELL
 NEAR GREENVILLE S. C.

Scale 1"=40 Oct. 1958

This is to certify that on the 30th day of October, 1958, I surveyed the property shown on this plat; being known as Lot 4 on plat of Jack O. Campbell, Recorded in Plat Book SS page 17, Office of R. M. C. Greenville Co., S. C.; and that the property lines, walls and buildings are as shown hereon; that the buildings located on said lot do not encroach or project on adjacent streets or property; and that no adjacent buildings or walls encroach or project on said premises; and that no utility lines cross this property except as shown hereon.

OLIE FARMWORTH
 R.M.C.

DEC 11 1958

Registered.

DEC 11 9 25 AM 1958

14778

FILED
 GREENVILLE CO. S. C.

81-68

14778 Filed This 11 day of Dec. 1958
 And Recorded in Vol. SS Page 18 of M
 Olie Farmworth
 Register Mesne Conveyance Greenville County, S. C.