

GREENVILLE CO. S. C.

MAR 26 3 40 PM 1959

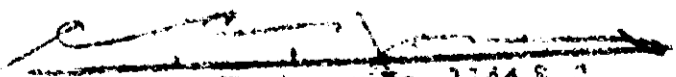
OLIVE ST. SOUTH

LOCKWOOD AVE.
SEWER & WATER LINES
UTILITY POLE

24960

504
SS-12.9 MAR 28 1959

This is to certify that on the 6th day of MARCH 1959, I surveyed the property shown on this plat, being Lot No. 83 - ELLETSON ACRES, as recorded in Plat Book 55 page 5 of the R.M.C. Office for Greenville County, S. C., and that the property lines, walls and buildings are as shown hereon; that the buildings located on said lot do not encroach or project on adjacent streets or property; and that no adjacent buildings or walls encroach or project on said premises; and that no utility lines cross this property.


Reg. Engineer No. 1144 S. C.

PROPERTY OF
C. E. PRATER
GREENVILLE S. C.
SCALE 1" = 10' MAR. 6 1959

JONES & SUTHERLAND-ENGINEERS
GREENVILLE S. C.

24960
SS-12.9
Edna Rowan
Greenville County, S. C.