Plat Book 5S, Page 170A

GREENVILLE CO. S. C.

JUN 19 2 53 PM 1959

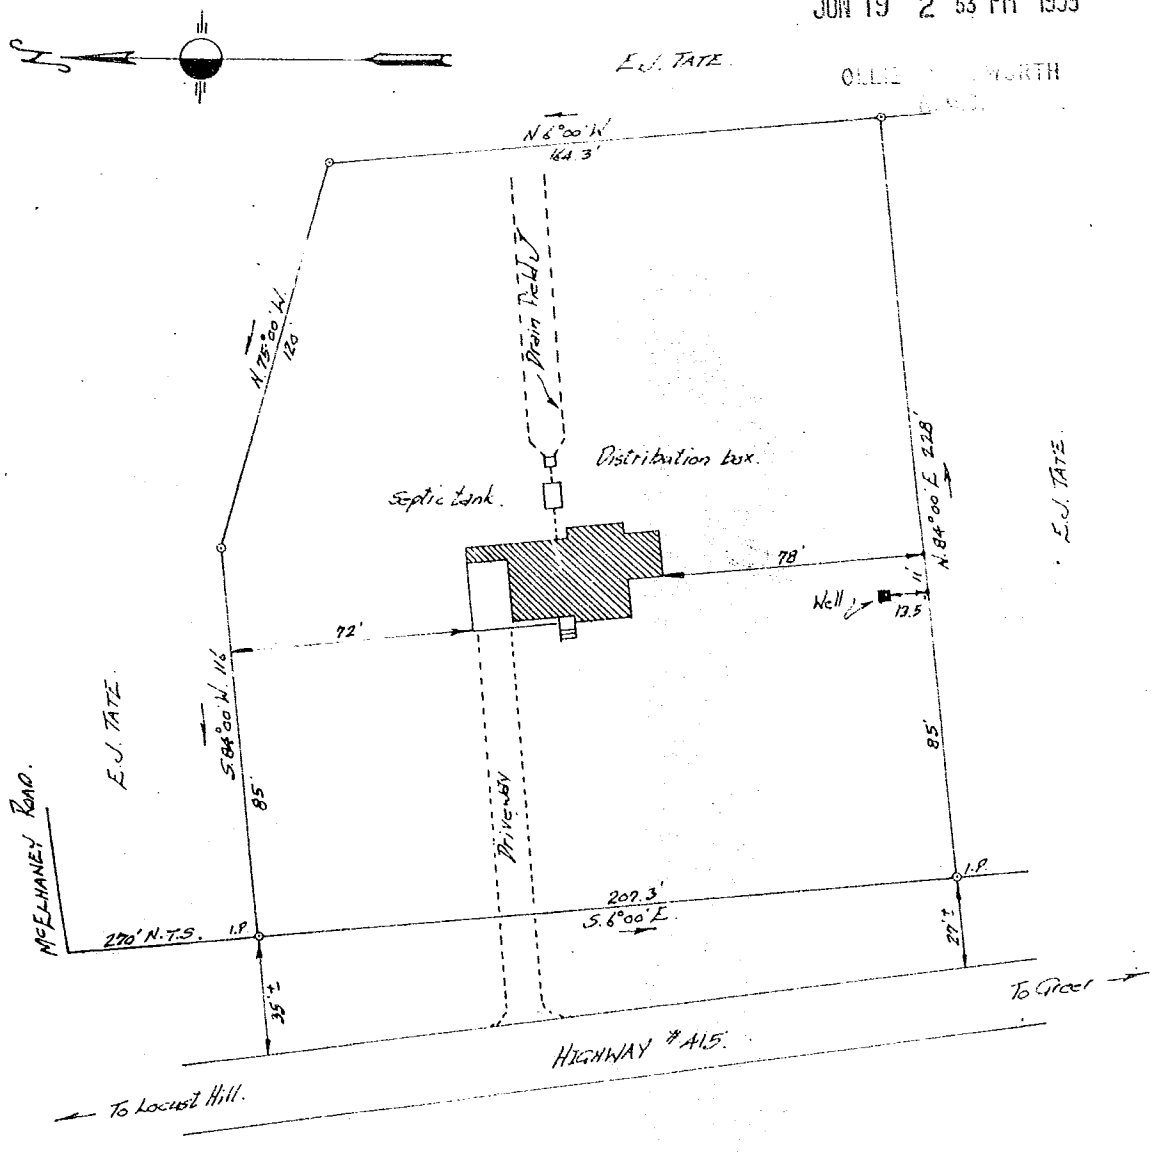


PROPERTY OF

W.B. MALLONEE.

Located 6 miles North West of Greer.

ONEAL TOWNSHIP GREENVILLE COUNTY.

SOUTH CAROLINA.

SCALE: 1" = 50 FEET. JUNE 11, 1959.

This is to certify that on June 11th, 1959, I ascertained and verified the property shown on this plat, and the same is correct, being a part of the W. B. Mallonee place, and that the property lines, walks and buildings shown thereon do not encroach or project on adjacent road or property, and that no adjacent walls or buildings encroach or project on said premises.

34208

H. S. Brockman

Registered Surveyor, Greenville County, S. C.

Filed This 19 day of June 59

at 8:45 A.M.

Clerk of Court

34208

504

SS-175

JUN 19 1959

BAD COPY