


# Plat Book TT, Page 95 B

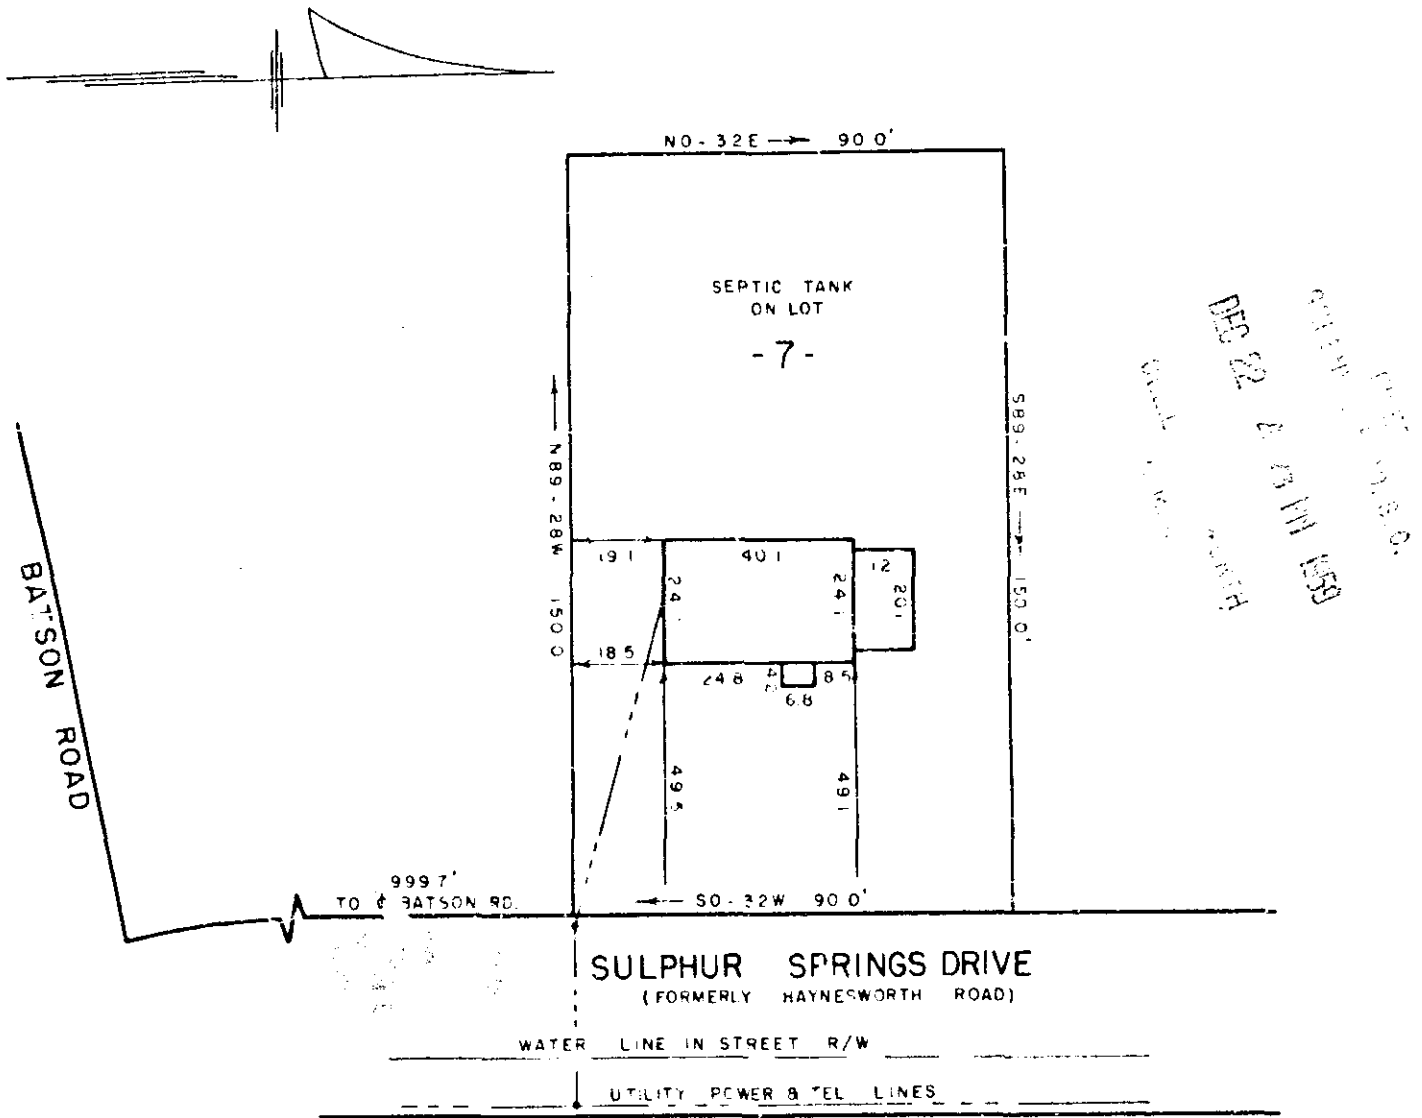

PROPERTY OF  
 RECTOR G. JONES &  
 IZA C. JONES  
 NEAR GREENVILLE, S.C.  
 SCALE 1" = 40' 4 DEC. 1959

This is to certify that on the 4 day of December, 1959, I surveyed the property shown on this plat, being known as lot 7 on plat of property of Rector G. Jones & Iza C. Jones, recorded in R.M.C. Office Greenville County, in plat book "TT" page 95, and also known as portion of R.G. Jones & Iza C. Jones recorded in plat book "DD" page 107, and that the property lines, walls and buildings, are as shown hereon, and that the buildings located on said lot do not encroach or project on adjacent street or property, and that no adjacent buildings or walls encroach or project on said premises.

*R. B. Bruce*  
 R.B. Bruce, R.L.S. No. 1952.

18166

DEC 22 1959

TT-95 Paste in 50d

18166 Filed This 22<sup>nd</sup> day of Dec. 1959  
 and Recorded in Plat TT, Page 95  
*Adelle Sanson*  
 Register Mesm. Conveyance Greenville County, S.C.