


Plat Book TT, Page 97 IA

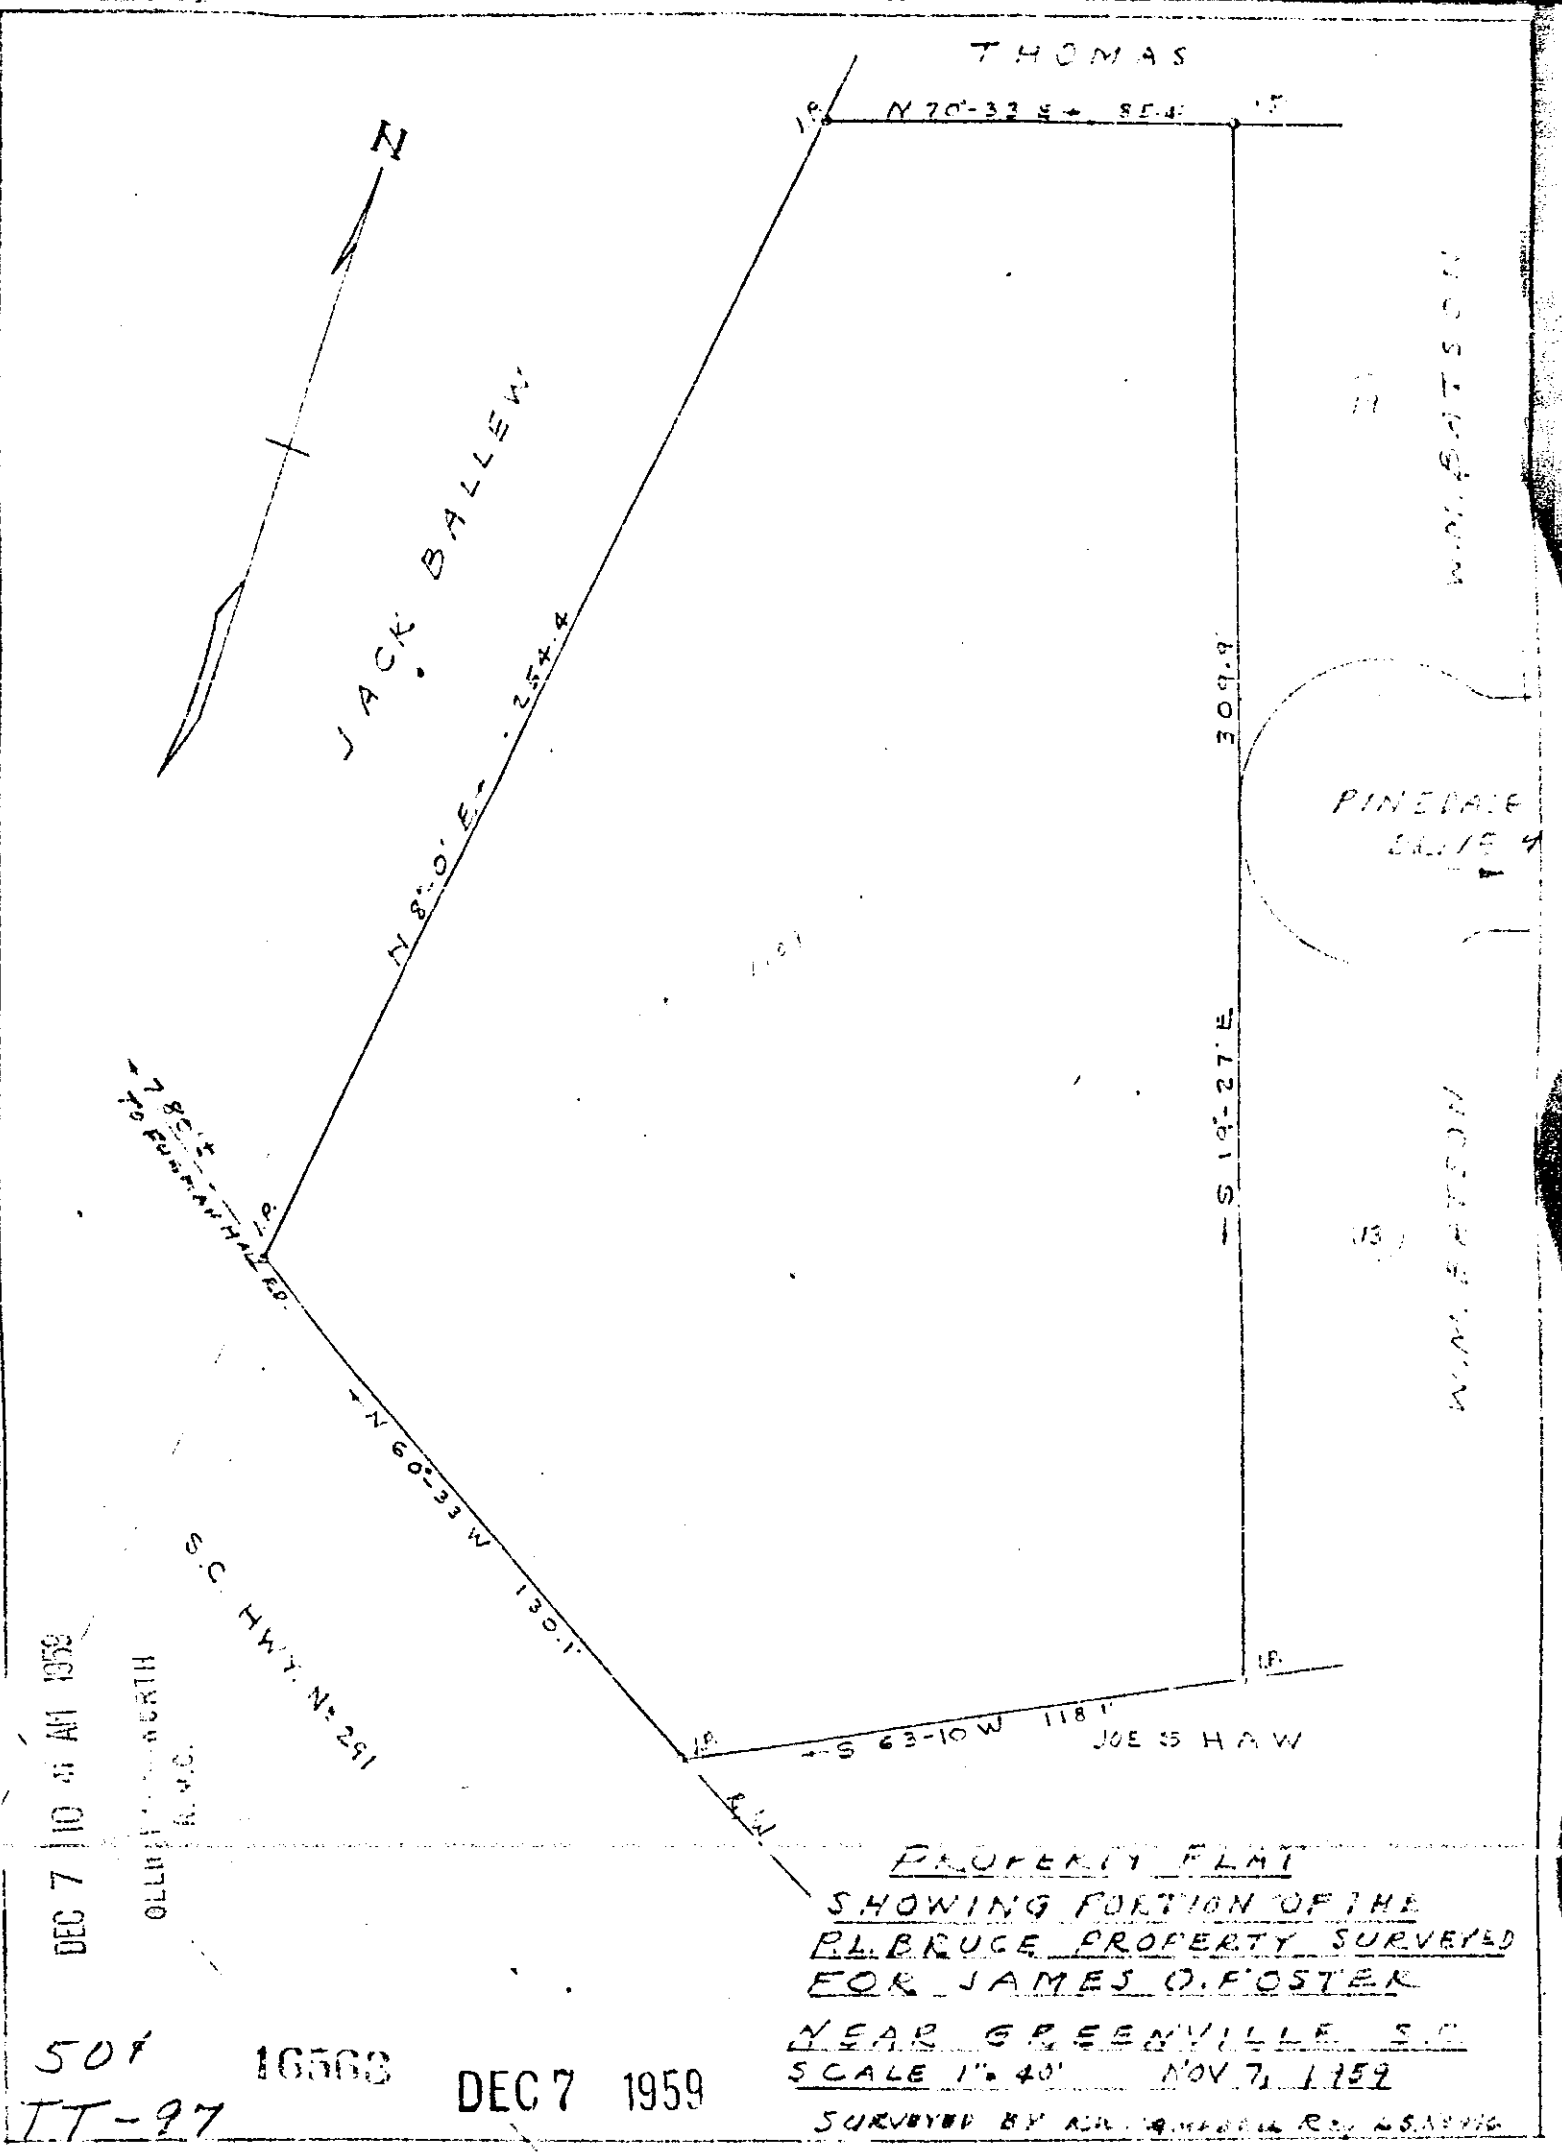

16563 Filed This 7 day of Dec 1959
and Recorded in TT-97
Alb. W. Harris

Deputy Registrar, Greenville County, S. C.