

Plat Book TT, Page 171 D

REF: PLAT OF MAPLE HEIGHTS, PROPERTY OF MARSHALL VAUGHAN, (UNRECORDED)
 FILED IN PLAT BOOK "TT" PAGE 161


501

25742

MAR 21 1960

MAR 21 12 42 PM 1960

OLLIE BARKER WORTH
 R.M.O.

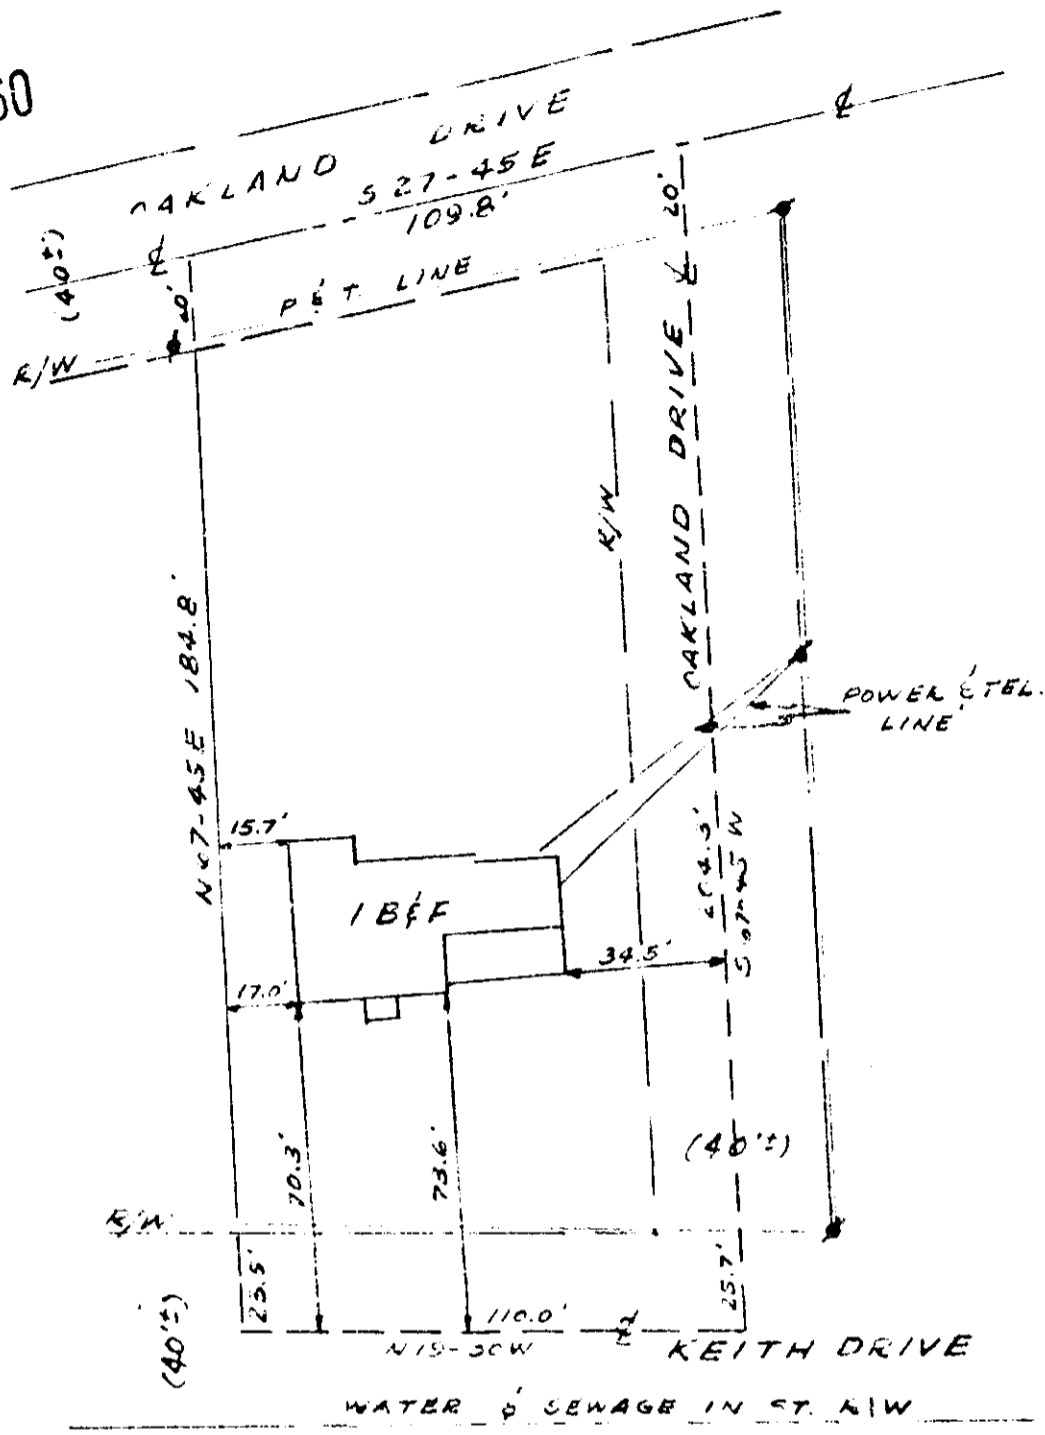

PROPERTY OF
PATRICIA P. BRUNS
 GREENVILLE, S.C.

SCALE 1"=50' MARCH 12, 1960

This is to certify that on the 12th day of March 1960 I surveyed the property shown on this plat, and that the property lines, walls and buildings are as shown hereon; that the buildings located on said lot do not encroach or project on adjacent streets or property, and that no adjacent walls or buildings encroach or project on this lot; and that there are no utility lines crossing this property except as shown.

Signature of Registered Engineer

Registered Engineer
 No. 962

PIEDMONT ENGINEERING SERVICE
 GREENVILLE, S. C.



TT-171

25742 Filed This 21 day of Mar. 1960

And Recorded in Vol. TT Page 171 of

Signature of Register
 Register Meine Conveyance Greenville County, S. C.

4617