


MAR 17 4 58 PM 1961

OLIVER HAYNSWORTH
N.W.C.

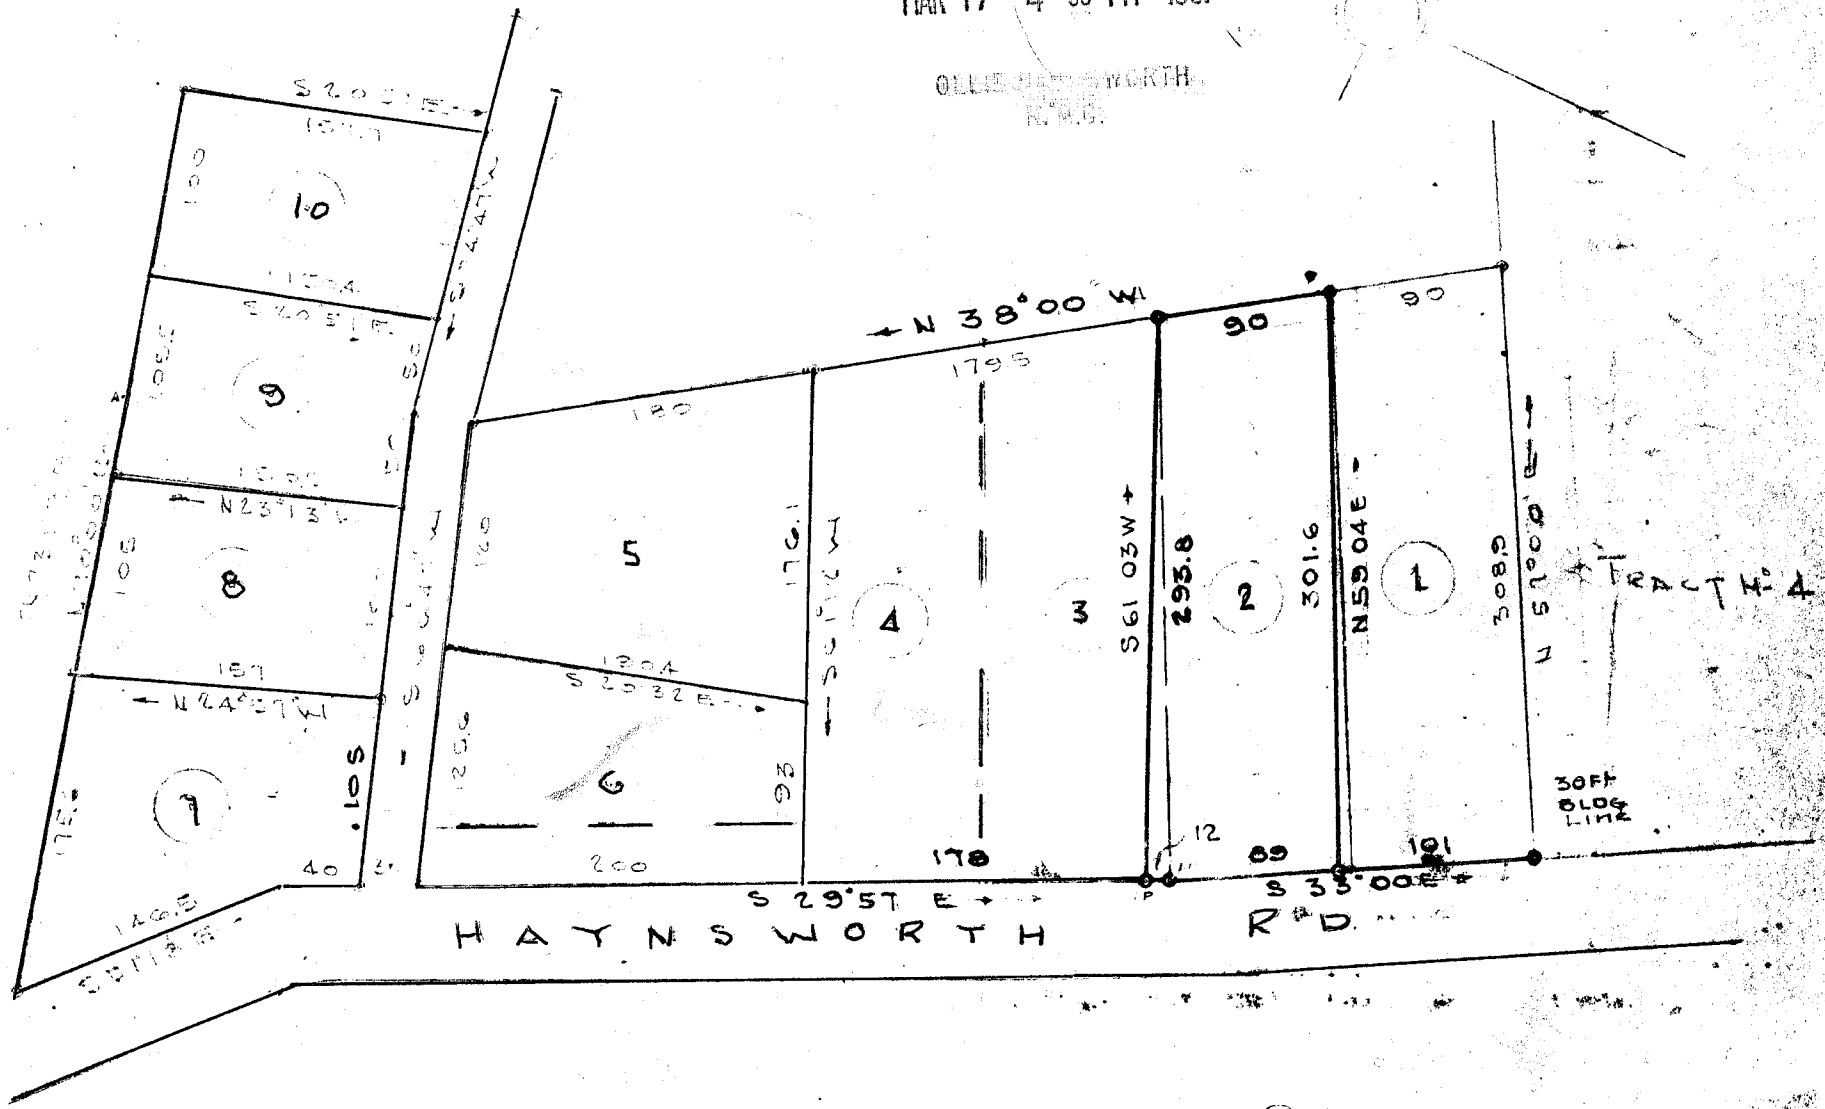

VV-61

MAR 17 1961

W. H. McCRARY

22951

GREENVILLE, S.C.

C. C. JONES - CIVIL ENGINEER
GREENVILLE, S.C.

NOTE: Revision of TRACT 5; 117-118
FARR ESTATE - 5-1-1958
By W. J. RIDGEMAN, 5-21-1958
LOTS 1-2-3-4 Revised MAR 1961

22951 Filed This 17 day of March 1961
And Recorded in Vol. 117 Page 61 at
C. C. JONES
Register Means Convenience Greenville County, S. C.