


137 WOOD ACRES

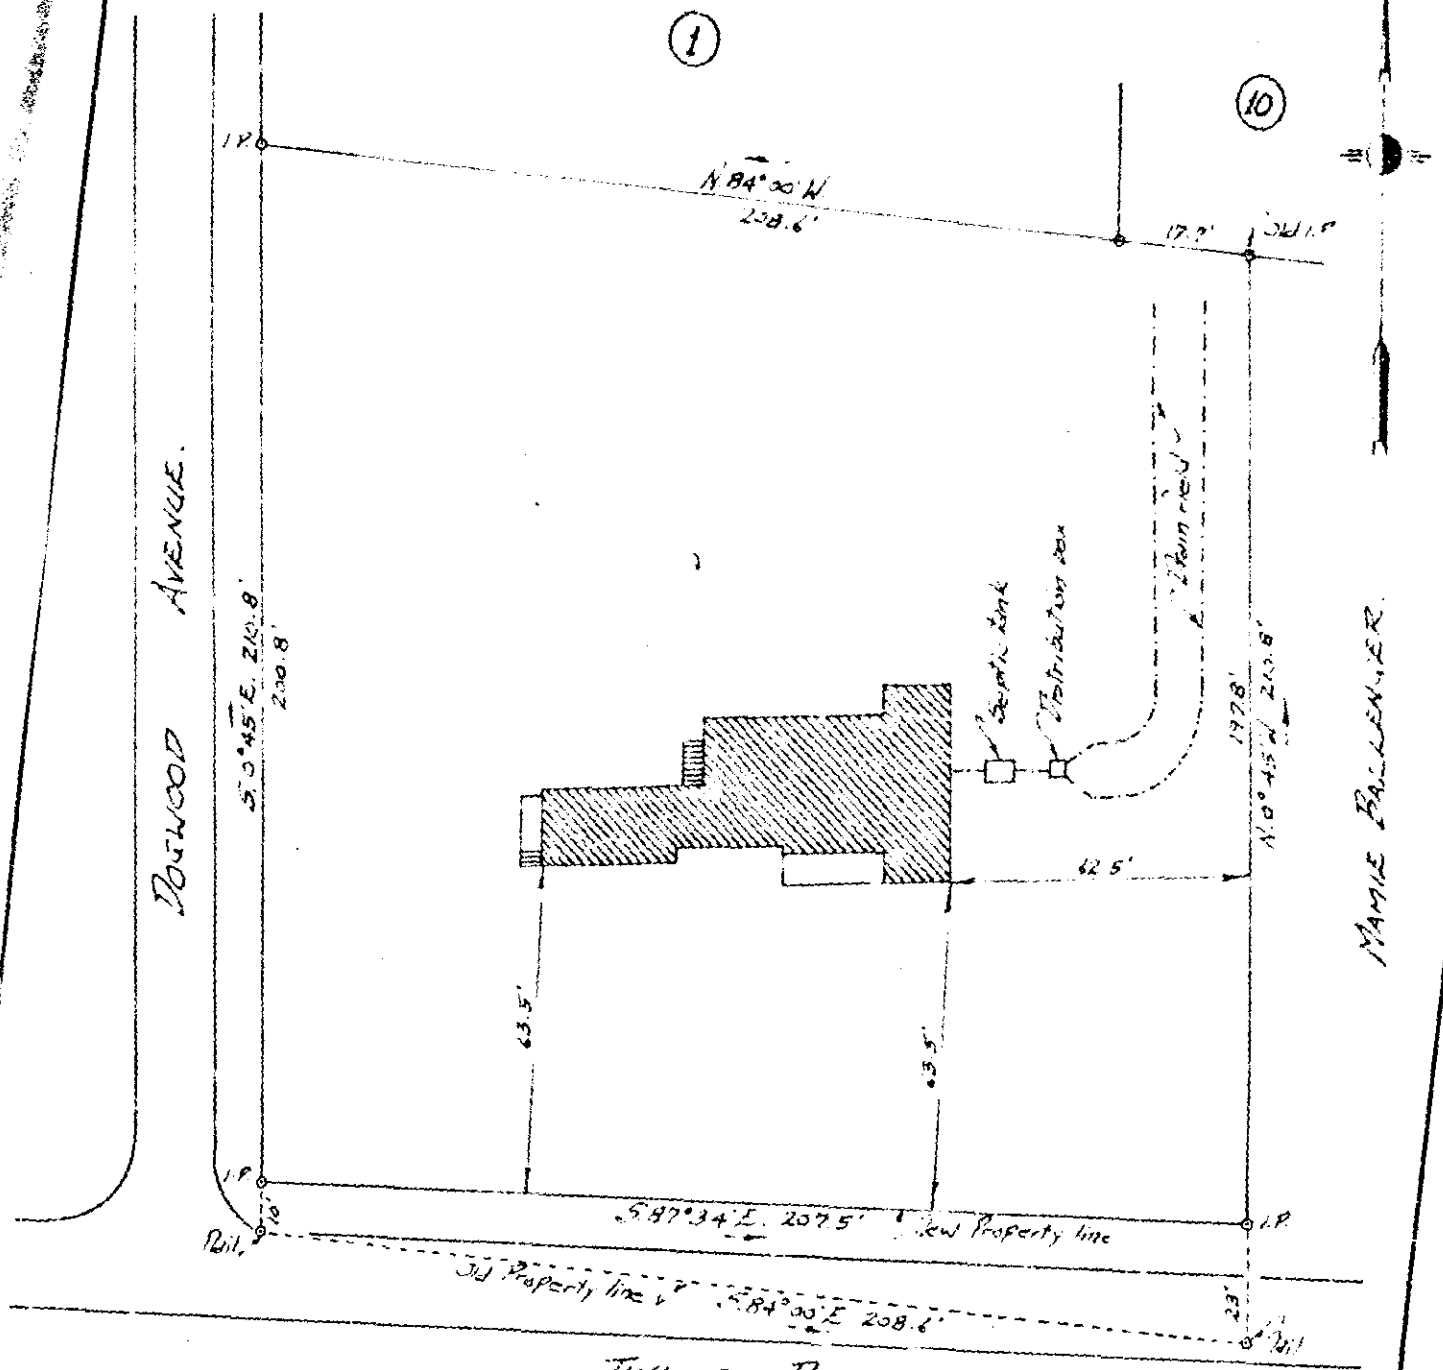

DOGWOOD AVENUE

MAMIE BALLENGER

TAYLOR ROAD

PROPERTY OF  
CARLOS H. BALLENGER

Located approx 2 miles N.W. of Greer  
OYEALE TOWNSHIP - GREENVILLE COUNTY  
SOUTH CAROLINA

MAY 13 1961

SCALE 1" = 40 FEET

MAY 13 1961 28021

This is to certify that on May 10th 1961, I surveyed the property shown on this plat, and the same is correct, being the same tract of land conveyed to E. Dennis Smith from Joan S. Bailey June 19 1950, recorded in the office of the R. M. D. for Greenville County in Book 421, at Page 73, lying on the North side of Taylor Road, at intersection of Dogwood Avenue, and that the property lines, walls and buildings shown thereon, do not encroach or project on adjacent property, and that no adjacent walls or buildings encroach or project on said premises.

*[Signature]*  
Notar Public for Greenville County, S.C.

MAY 13 10 49 AM 1961

102

28021 Piled This 13 day of May 1961  
And Recorded in 102 YV File 102 at 11

*[Signature]*  
Register Anne Cunningham Greenville County, S.C.