

FILED  
 GREENVILLE CO. S.C.  
 AUG 4 12 52 PM 1961

**LEHMAN ADWELL MOSELEY, JR.**  
 ATTORNEY AT LAW  
 TRAVELERS REST, S. C.

**PARISVIEW AVE.**  
 WATER MAIN


This is to certify that on Aug. 1, 1961, I surveyed the property shown on this plat, known as the greater portion of Lot No. 2, and a small triangular portion of Lot No. 3 of plat of Lots 2 & 3, Sunny Acres, filed in R.M.C. Office for Greenville Co. in Plat Book VV at page 85, and that the property lines, walls and building are as shown hereon; that the building located on said lot does not encroach or project on adjacent streets or property, and that no adjacent walls or buildings encroach or project on said premises, and that no utility lines cross this property except as shown hereon.

**AUG 4 1961**  
**3489**

surveyed by R.K. Campbell

S.C. Reg. No. 996

PROPERTY OF  
**James Deiane Johnson & Jane G. Johnson**  
 TRAVELERS REST S.C.  
 SCALE 1"=30' AUG. 1, 1961

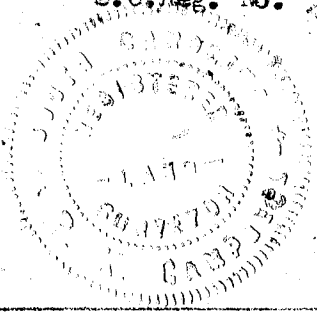

**P.B. VV - 146** parts in .50

3489 FILED THIS 4<sup>th</sup> DAY OF AUGUST 1961  
 And Recorded VV - 146 at  
Assie Samsworth  
 Register Meane Conveyance Greenville County, S.C.