


This is to certify that on June 1, 1960, I surveyed the property shown on this plat, being known as Lot Nos 19, 20, and the south portion of Lots 21, 22, and 23 as shown on plat of Norwood Heights, filed in R.M.C. Office for Greenville Co. in Plat Book E page 217, and that the property lines, walls and buildings are as shown hereon; that the building located on said plat does not encroach or project on adjacent streets or property, and that no adjacent walls or buildings encroach or project on said premises, and that no utility lines cross this property except as shown hereon.

Surveyed by L.K. Campbell

S.C. Reg. No. 996

1828
JUL 15 1961

PROPERTY OF
WILLETTE D. ANDERSON
CHARLES E. ANDERSON
LOCATED AT WEST GREENVILLE
IN CITY OF GREENVILLE S.C.

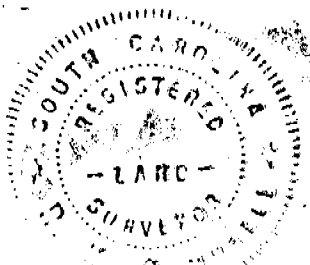

Recorded July 15, 1961 at 11:28 A.M. #1828

SCALE 1"=20' JUNE 1, 1961