


YOUNG & SPENCE

SEP 20 10 20 AM 1961

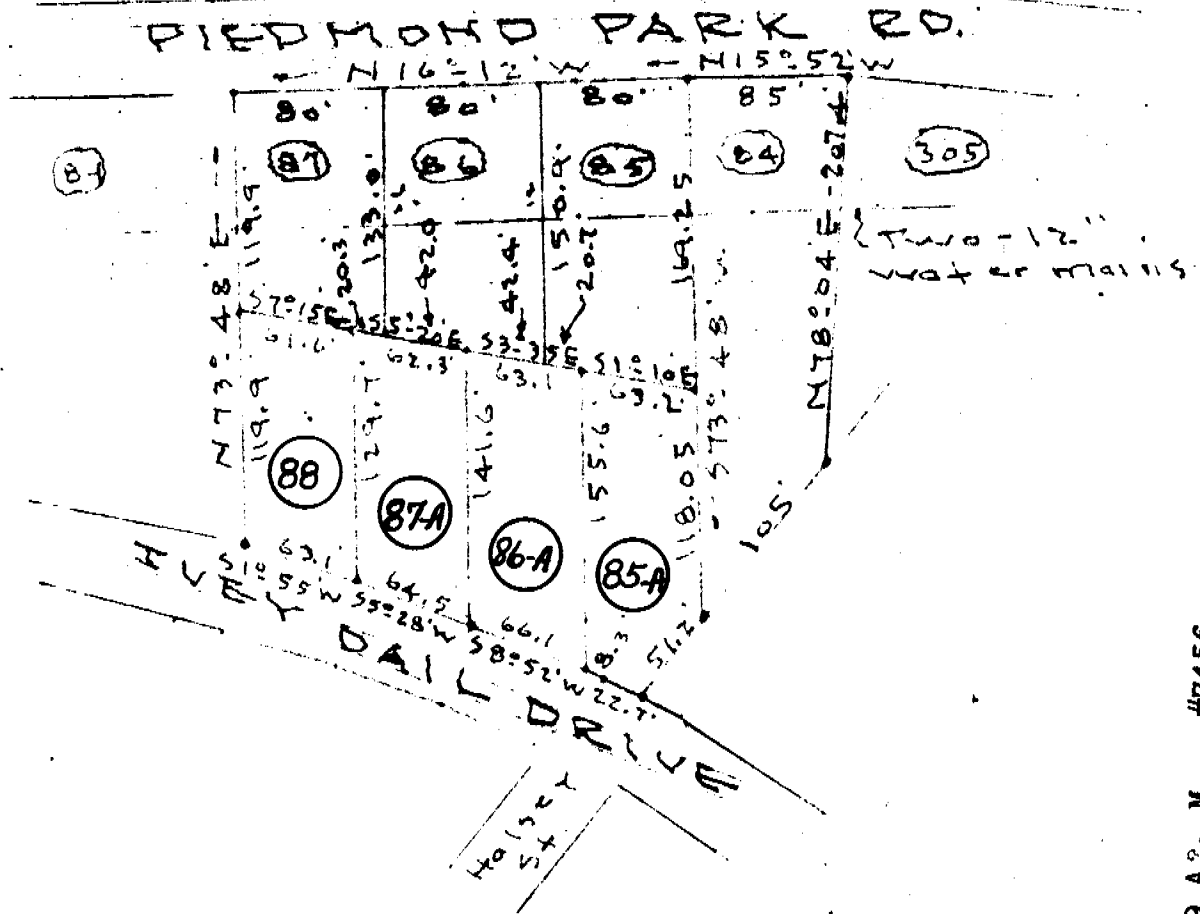

PROPERTY OF
 JOHN W. CAULEY
 Lot 84 & Re-sub. lots 85-88 Incl. Piedmont Ests.
 Paris Station - Greenville Co. S.C.
 Scale 1" = 100' - June - 6 - 56.
 Revised on plat - June - 5 - 61 - Not surveyed.

WW-159

SEP 20 1961

7456

Picture \$1.00

Iron pins at all corners.

J.C. Hill - L.S. 805

Recorded September 20, 1961 at 10:29 A.M. #7456