
## Plat Book WW, Page 285

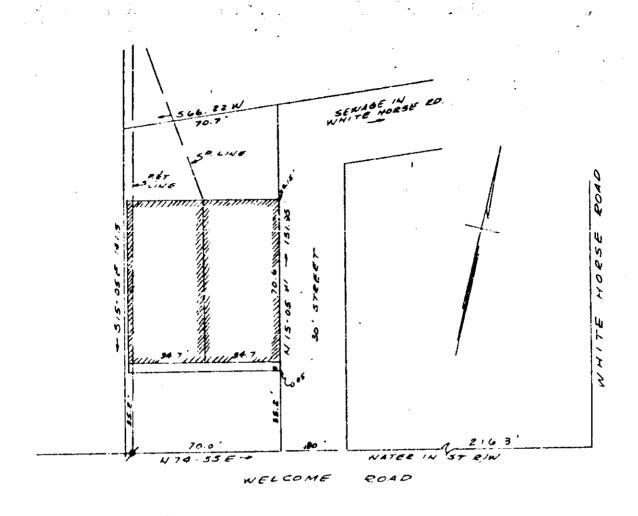

PROPERTY OF

C. T. TUCKER & P. V. TUCKER

NEAR GREENVILLE, S.C.

SCALE 1": 40' MAY 1962

This is to certify that on the 18th day of May 1962, I surveyed the property shown on this plat, being known as a portion of W.B.McClain property, recorded in the R.H.C.Office Greenville County, S.C. in plat book "TT" page 106; and that the property lines, walls and buildings are as shown hereon, and that the buildings located on said lot do not encroach or project on adjacent street or property, and that no adjacent cuildings or walls encroach or project on said premises other than shown on this plat.

29219

MAY 25 1962

R.B. Bruce.

Recorded May 25, 1962 at 10:29 A: M. #29219