

We, Alice O. Martin and A. J. Goforth, Jr., are parties to a Contract of Sale, which is recorded in the Office of the R.M.C. for Greenville County, S. C. in Deeds Book 692, Page 547, and we agree that the real property which was conveyed by Alice O. Martin to Henry T. Berry, by deeds which are recorded in said Office in Deeds Book 671, Page 1, and in Deeds Book 711, Page 141, is not included in said Contract of Sale and is as shown on this plat.

WITNESSES:

Thomas A. Babb Alice O. Martin  
ALICE O. MARTIN

Alice P. Alexander

November 19, 1962

WITNESSES:

Calhoun Turner A. J. Goforth, Jr.  
A. J. GOFORTH, JR.

Barbara Gambell

November 14, 1962

STATE OF SOUTH CAROLINA  
COUNTY OF Laurens

PERSONALLY appeared before me Thomas A. Babb and made oath that (s)he saw the within named Alice O. Martin sign, seal and as her act and deed deliver the within written Statement, and that (s)he with Alice P. Alexander witnessed the execution thereof.

Thomas A. Babb

SWORN to before me this 19 day of November, 1962.

Alice P. Alexander  
Notary Public for South Carolina


STATE OF SOUTH CAROLINA  
COUNTY OF GREENVILLE

PERSONALLY appeared before me Barbara Gambell and made oath that (s)he saw the within named A. J. Goforth, Jr. sign, seal and as his act and deed deliver the within written Statement, and that (s)he with Calhoun Turner witnessed the execution thereof.

Barbara Gambell

SWORN to before me this 14th day of November, 1962. ← 1496' To Old Stewart Academy Rd.

Calhoun Turner  
Notary Public for South Carolina

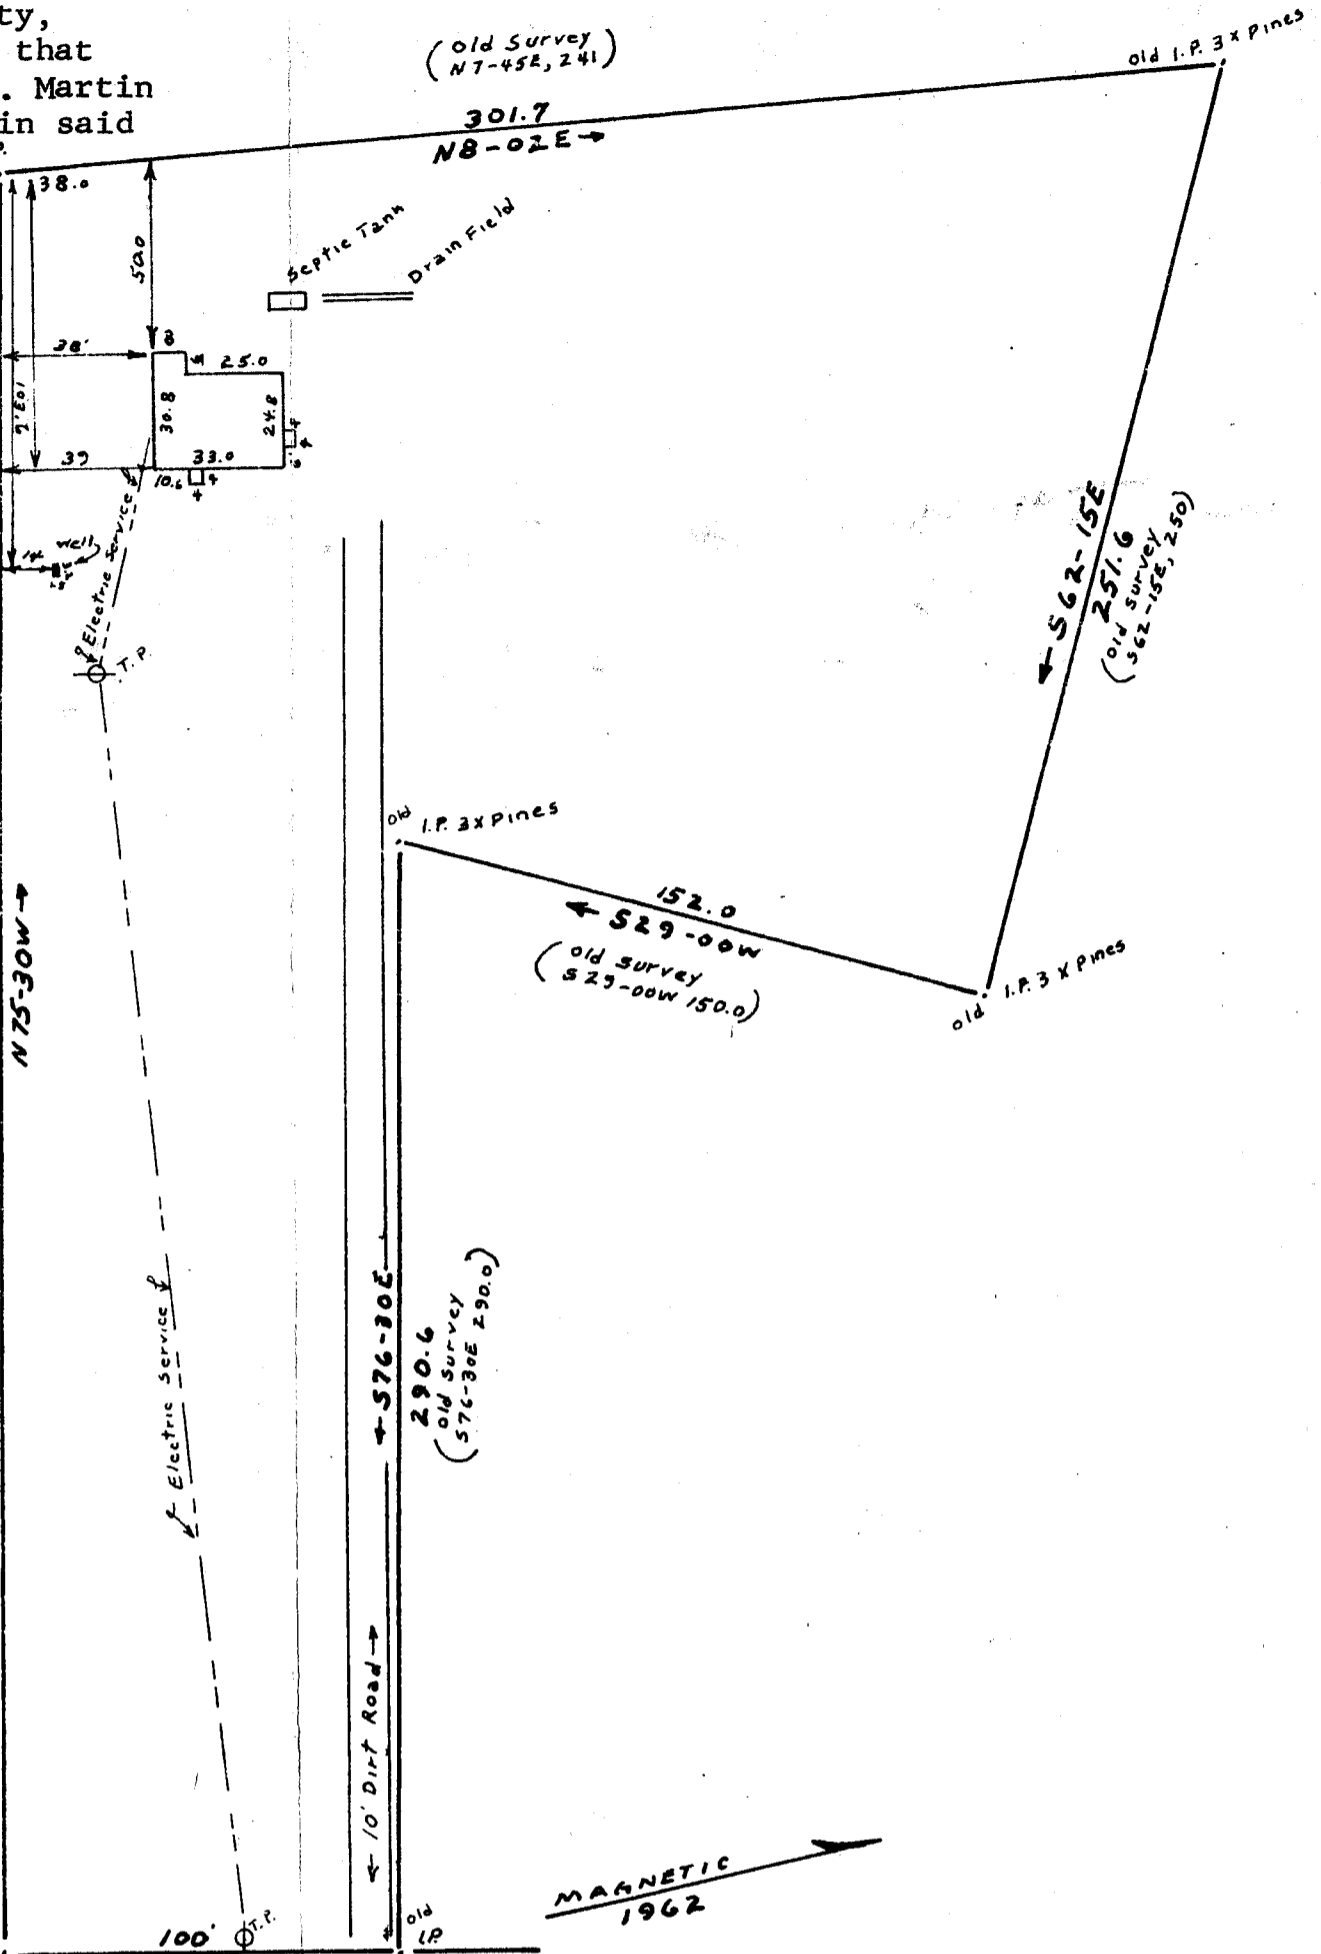

COUNTY ROAD  
PROPERTY  
OF  
HENRY T. BERRY  
NEAR SIMPSONVILLE, S. C.

SCALE 1" = 50'

13 OCT, 1962

This is to certify that on the 13th day of October, 1962 I surveyed the property shown on this plat being known as Plat of Property of Henry T. Berry by R. M. Clayton, dated March 23, 1961 and recorded in Plat Book VV at page 67, Office of the R. M. C., Greenville County, S. C.; and that the property lines, walls and buildings are as shown hereon; and that the buildings located on said lot do not encroach or project on adjacent streets or property; and that no adjacent buildings or walls encroach or project on said premises; and that no utility lines cross this property except as shown hereon.

FILED  
GREENVILLE CO. S. C.  
NOV 20 12 10 PM 1962  
OLLIE FARNSWORTH  
R. M. C.

T. C. Adams 77-95  
T. C. Adams  
Reg. Engineer #307

200  
NOV 20 1962 13304

13304 Filed This 20 day of Nov. 19 62  
And Recorded in Vol. 72 Page 95 at  
Ollie Farnsworth  
Register Mesne Conveyance Greenville County, S. C.