GREENVILLE CO. S. C.

JAN 22 2 17 PM 1963

OLLIE FARNSWORTH
R.M.C.

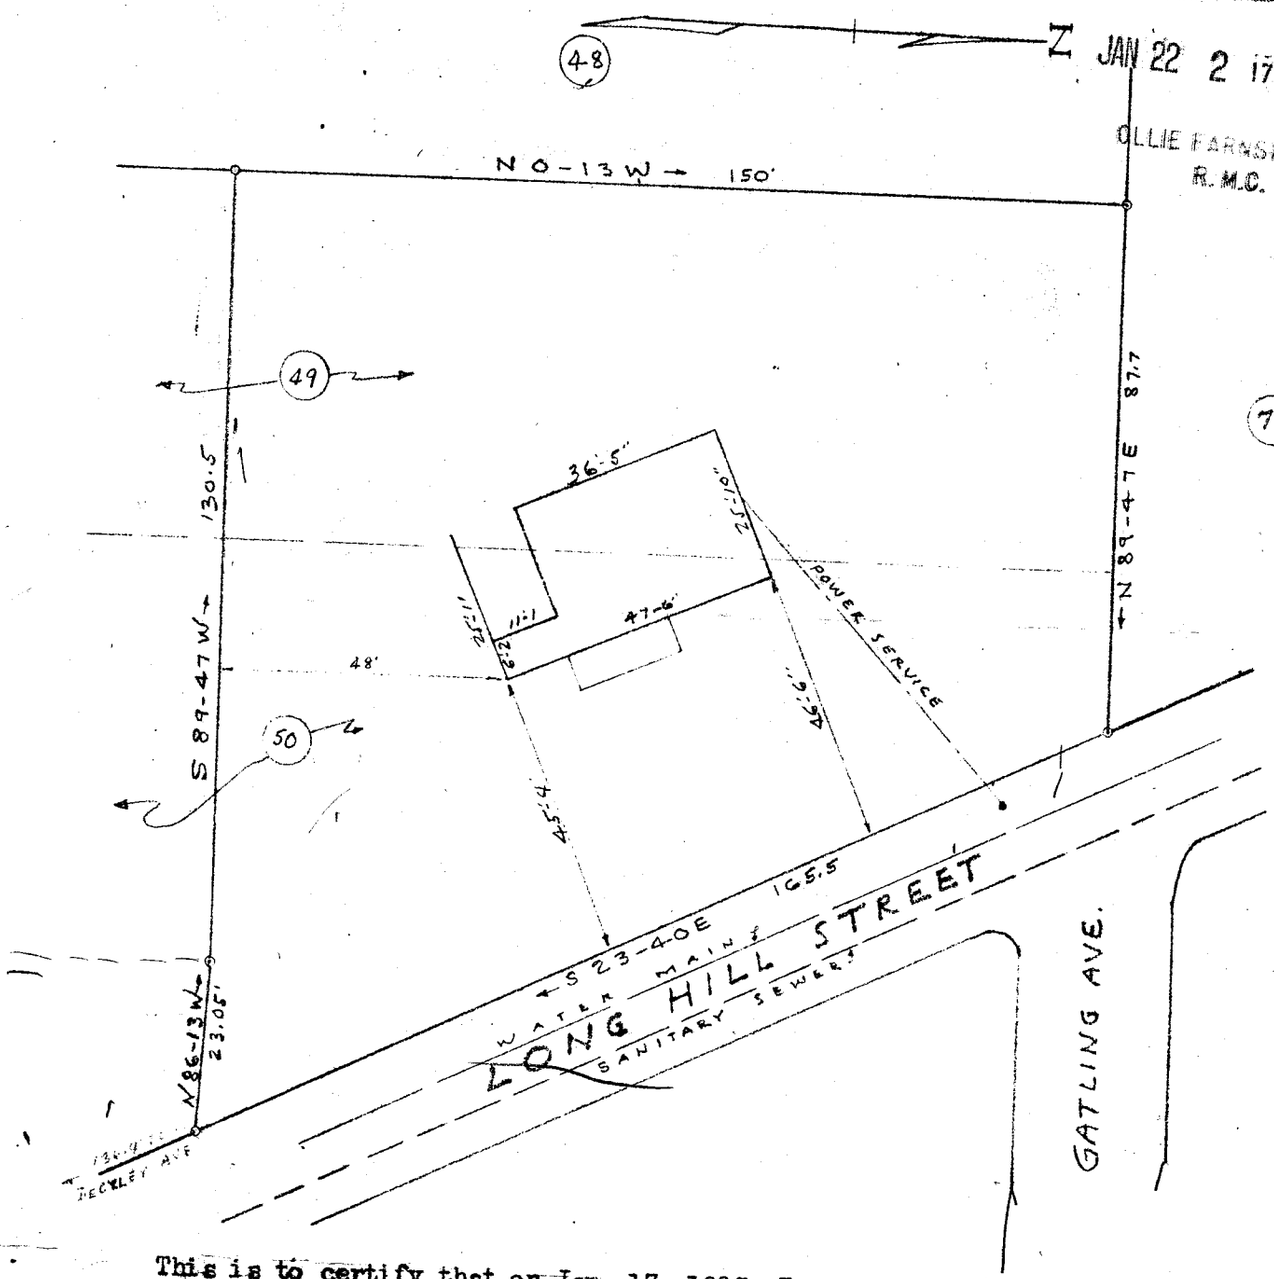

This is to certify that on Jan. 17, 1963, I surveyed the property shown on this plat, known as the northern half of Lot No. 49, and the northern portion of Lot No. 50, plat of Augusta Road Ranches, filed in the R.M.C. Office for Greenville Co. in Plat Book M at page 47, and that the property lines, walls and building are as shown hereon; that the building located on said lot does not encroach or project on adjacent streets or property, and that no adjacent walls or buildings encroach or project on said premises, and that no utility lines cross this property except as shown hereon.

18542

Surveyed by R.K. Campbell

S.C. Reg. No. 996

JAN 22 1963

PROPERTY OF

WILLIAM P. KELLER & JAMELLE M. KELLER

GREENVILLE S.C.

SCALE 1" = 30' JAN. 17, 1963

"CCC", 101

LEHMAN A. MOSELEY, JR., ATTORNEY
LAWYERS BLDG. — P. O. Box 10,345
GREENVILLE, S. C. — PH. 232-5419

See 504

18542 Filed This 22 day of Jan. 19 63

And Recorded in Vol. CCC Page 101 at M

Odie Farnsworth

Register Mesne Conveyance Greenville County, S. C.