


EAST PERRY ROAD

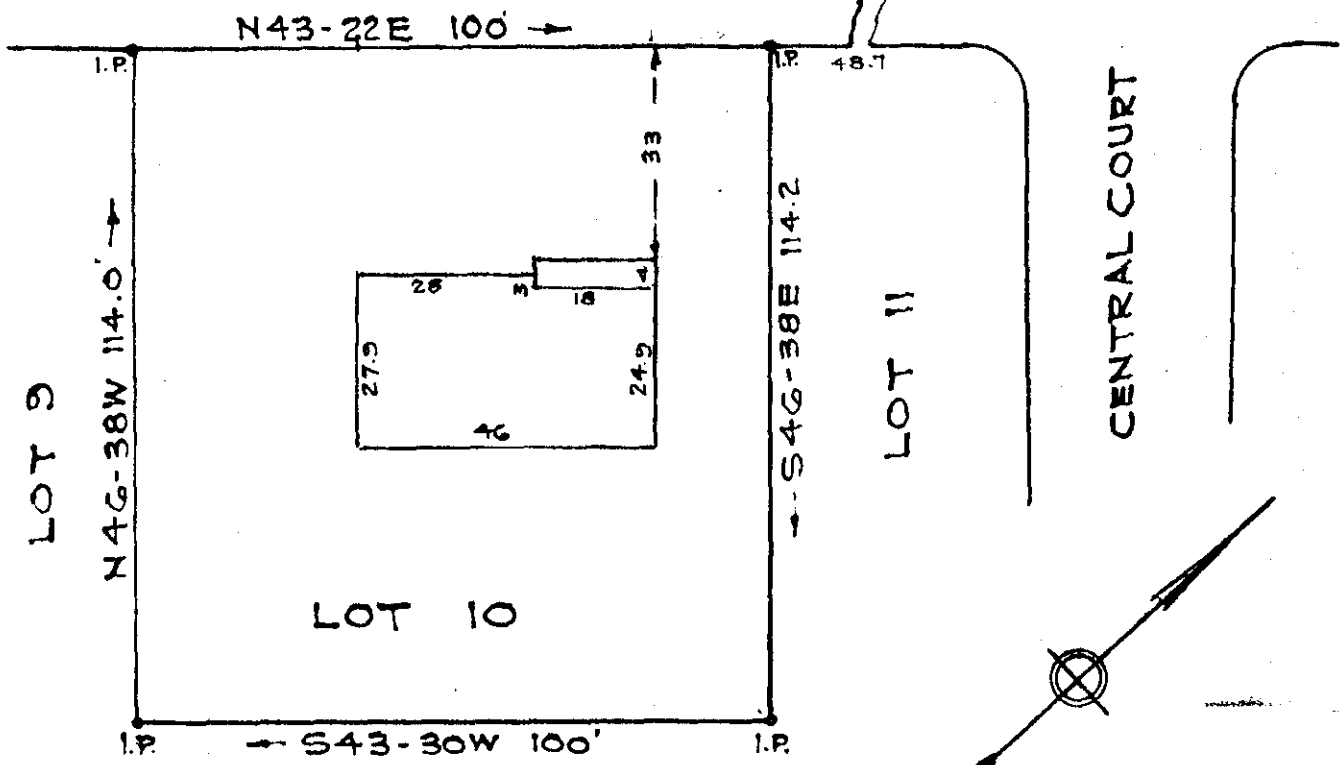

SUNSET HILLS

PROPERTY OF
 ROY FOSTER JOHNSON
 CAROLYN O. JOHNSON
 NEAR GREENVILLE S. C.
 Scale 1"=30' March 1963

FILED
 GREENVILLE CO. S. C.
 APR 25 4 24 PM 1963
 OLLIE FARNSWORTH
 R. M. C.

This is to certify that on the 27th day of March, 1963, I surveyed the property shown on this plat; being known as Lot 10 on plat of Leawood Hills and also Lot 10 on plat of Roy Foster Johnson and Carolyn O. Johnson, Recorded in Plat Book CCC page 177, Office of R. M. C. Greenville Co., S. C.; and that the property lines, walls and buildings are as shown hereon; that the buildings located on said lot do not encroach or project on adjacent streets or property; and that no adjacent buildings or walls encroach or project on said premises.

APR 25 1963

R. W. Dalton
 DALTON & NEVES, ENGINEERS

27285

Paste in 50¢

351

CCC-177

27285 Filed This 25 day of April 1963

And Recorded in Vol. CCC Page 177 at

Ollie Farnsworth

Register Mesne Conveyance Greenville County, S. C.