


AUG 8 1963
1278

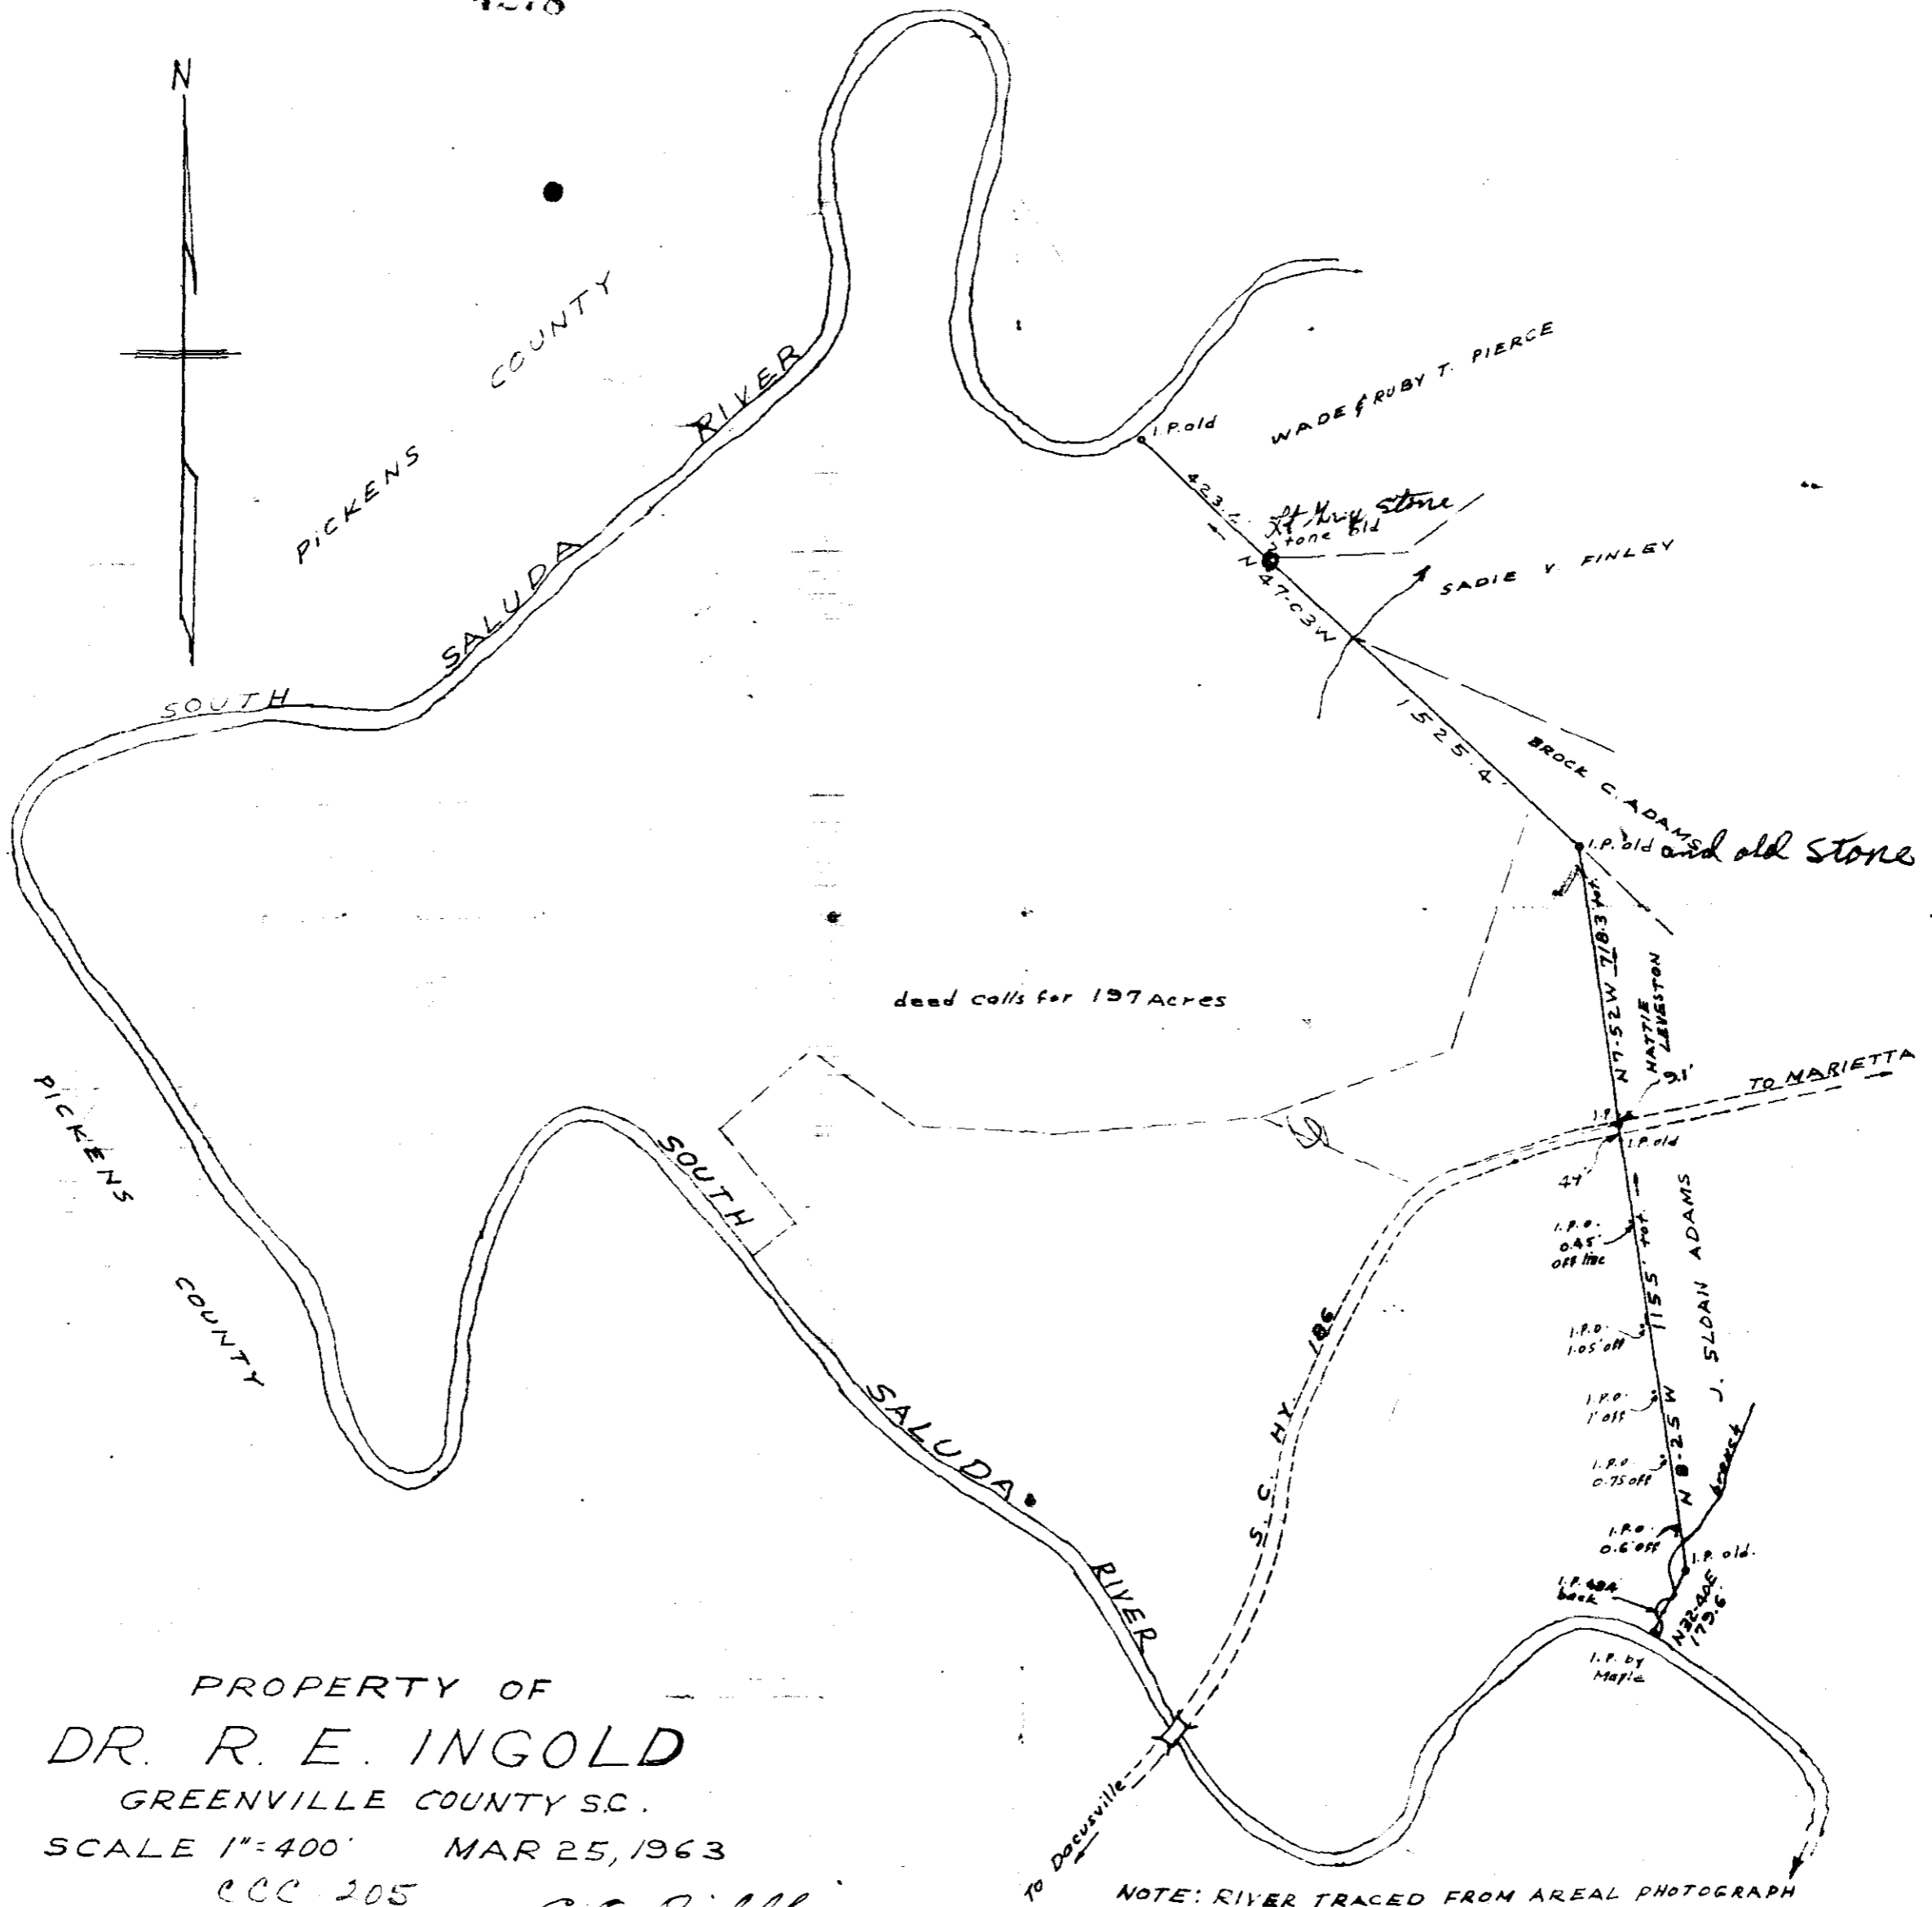

PROPERTY OF
DR. R. E. INGOLD
 GREENVILLE COUNTY S.C.
 SCALE 1"=400' MAR 25, 1963

CCC 205

C. C. Riddle Reg. L.S.

NOTE: RIVER TRACED FROM AREAL PHOTOGRAPH

4278 Filed This 8 day of Aug. 19 63
 And Recorded in Vol. CCC Page 205 at 9:30 AM
 C. C. Riddle
 Register Meane Conveyance Greenville County, S. C.

FILED 1:03 PM