
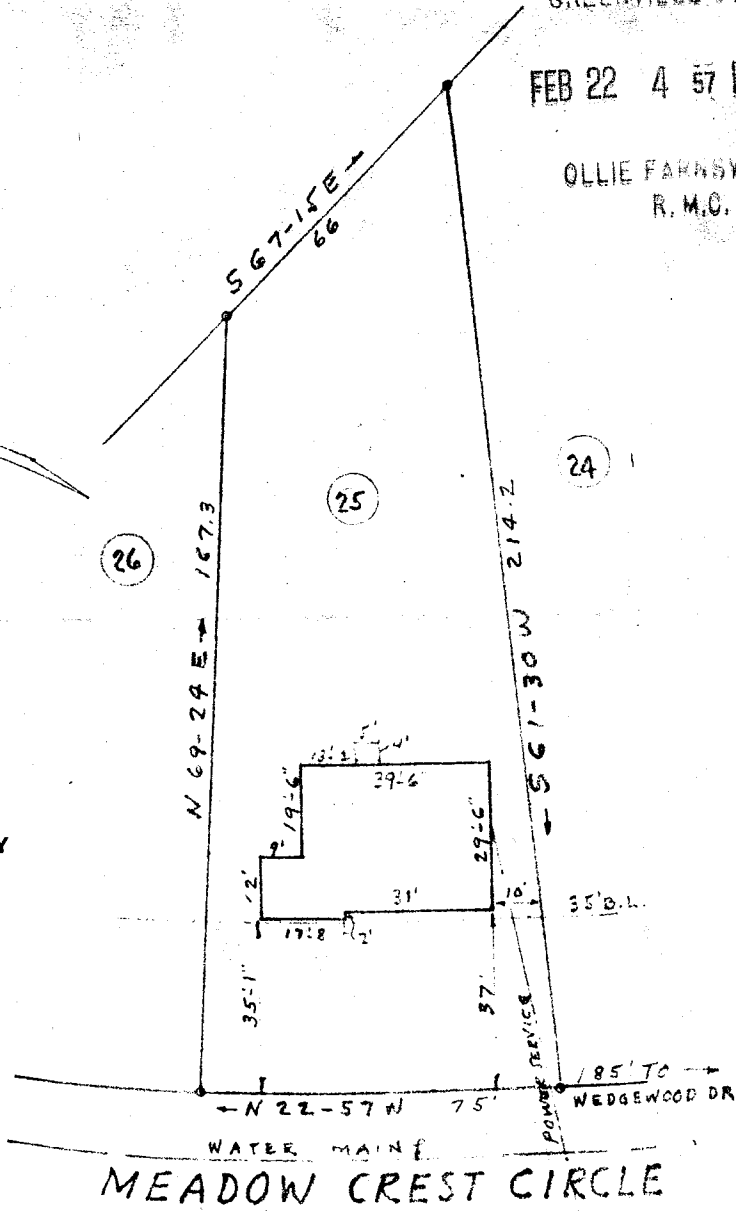


FILED
GREENVILLE CO. S. C.

FEB 22 4 57 PM 1963

OLLIE FARNSWORTH
R. M. C.

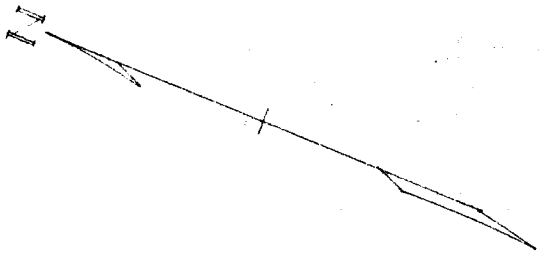

LEHMAN A. MOSELEY, JR., ATTORNEY
LAWYERS BLDG. - P. O. Box 10,345
GREENVILLE, S. C. - PH. 232-5419

This is to certify that on Feb. 20, 1963, I surveyed the property shown on this plat, known as Lot No. 25, plat of North Meadow Heights, filed in the R.M.C. Office for Greenville Co. in Plat Book W at page 183, and that the property lines, walls and building are as shown hereon; that the building located on said lot does not encroach or project on adjacent streets or property, and that no adjacent walls or buildings encroach or project on said premises, and that no utility lines cross this property except as shown hereon.

Surveyed by

R. Campbell

S.C. Reg. No. 996

PROPERTY OF

JAMES W. YOUNGBLOOD & REBA C. YOUNGBLOOD

NEAR GREENVILLE S.C.

FEB 22 1963

SCALE 1" = 40' FEB. 20, 1963

50f

21354

DDD-5

21354 Filed This 22 day of Feb. 19 63

And Recorded in Vol. DDD Page 5 at M

Ollie Farnsworth
Register Mesne Conveyance Greenville County, S. C.