


JUL 29 1963
3161

FILED
GREENVILLE CO. S. C.
JUL 29 9 17 AM 1963
OLLIE F. HENWORTH
R.M.C.

NOTE: There is a five foot
drainage easement along all
side and rear lot lines - lots
1-6.

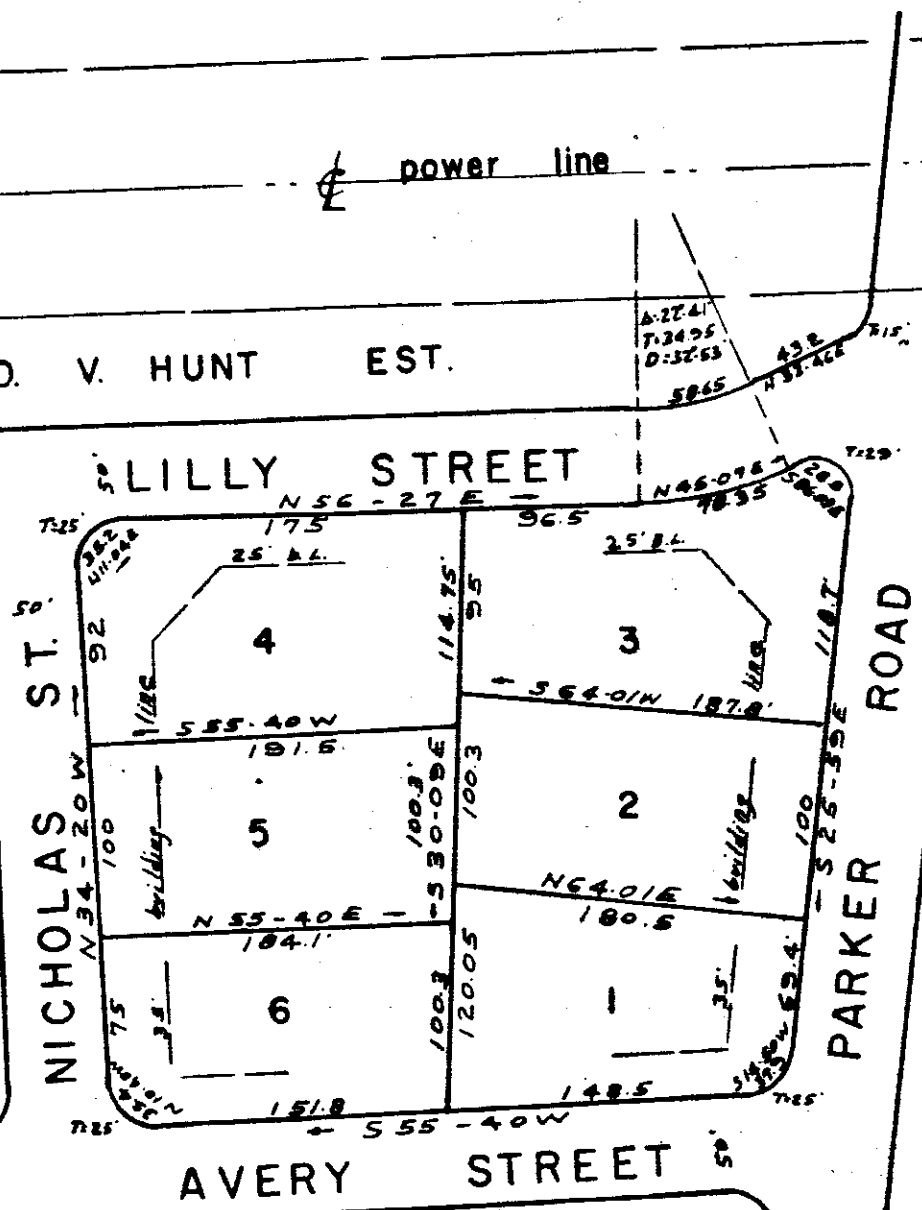

AVERY STREET

HUGHES HEIGHTS

NOTE: LOTS 1, 2 & 3 REVISED TO
ALLOW FOR ADDITIONAL PARKER
ROAD RIW, AND PLAT REVISED 7/20/61

PROPERTY OF
O. V HUNT ESTATE
NEAR GREENVILLE S.C.
SCALE 1"=100' NOV., 1959

192
75
267

218.7
89.4
288.1

DD-145
500

3161 Filed This 29 day of July 1963
And Recorded in Vol. P.D.D. Page 185 at M

[Signature]
Register Mesne Conveyance Greenville County, S. C.