


63-103

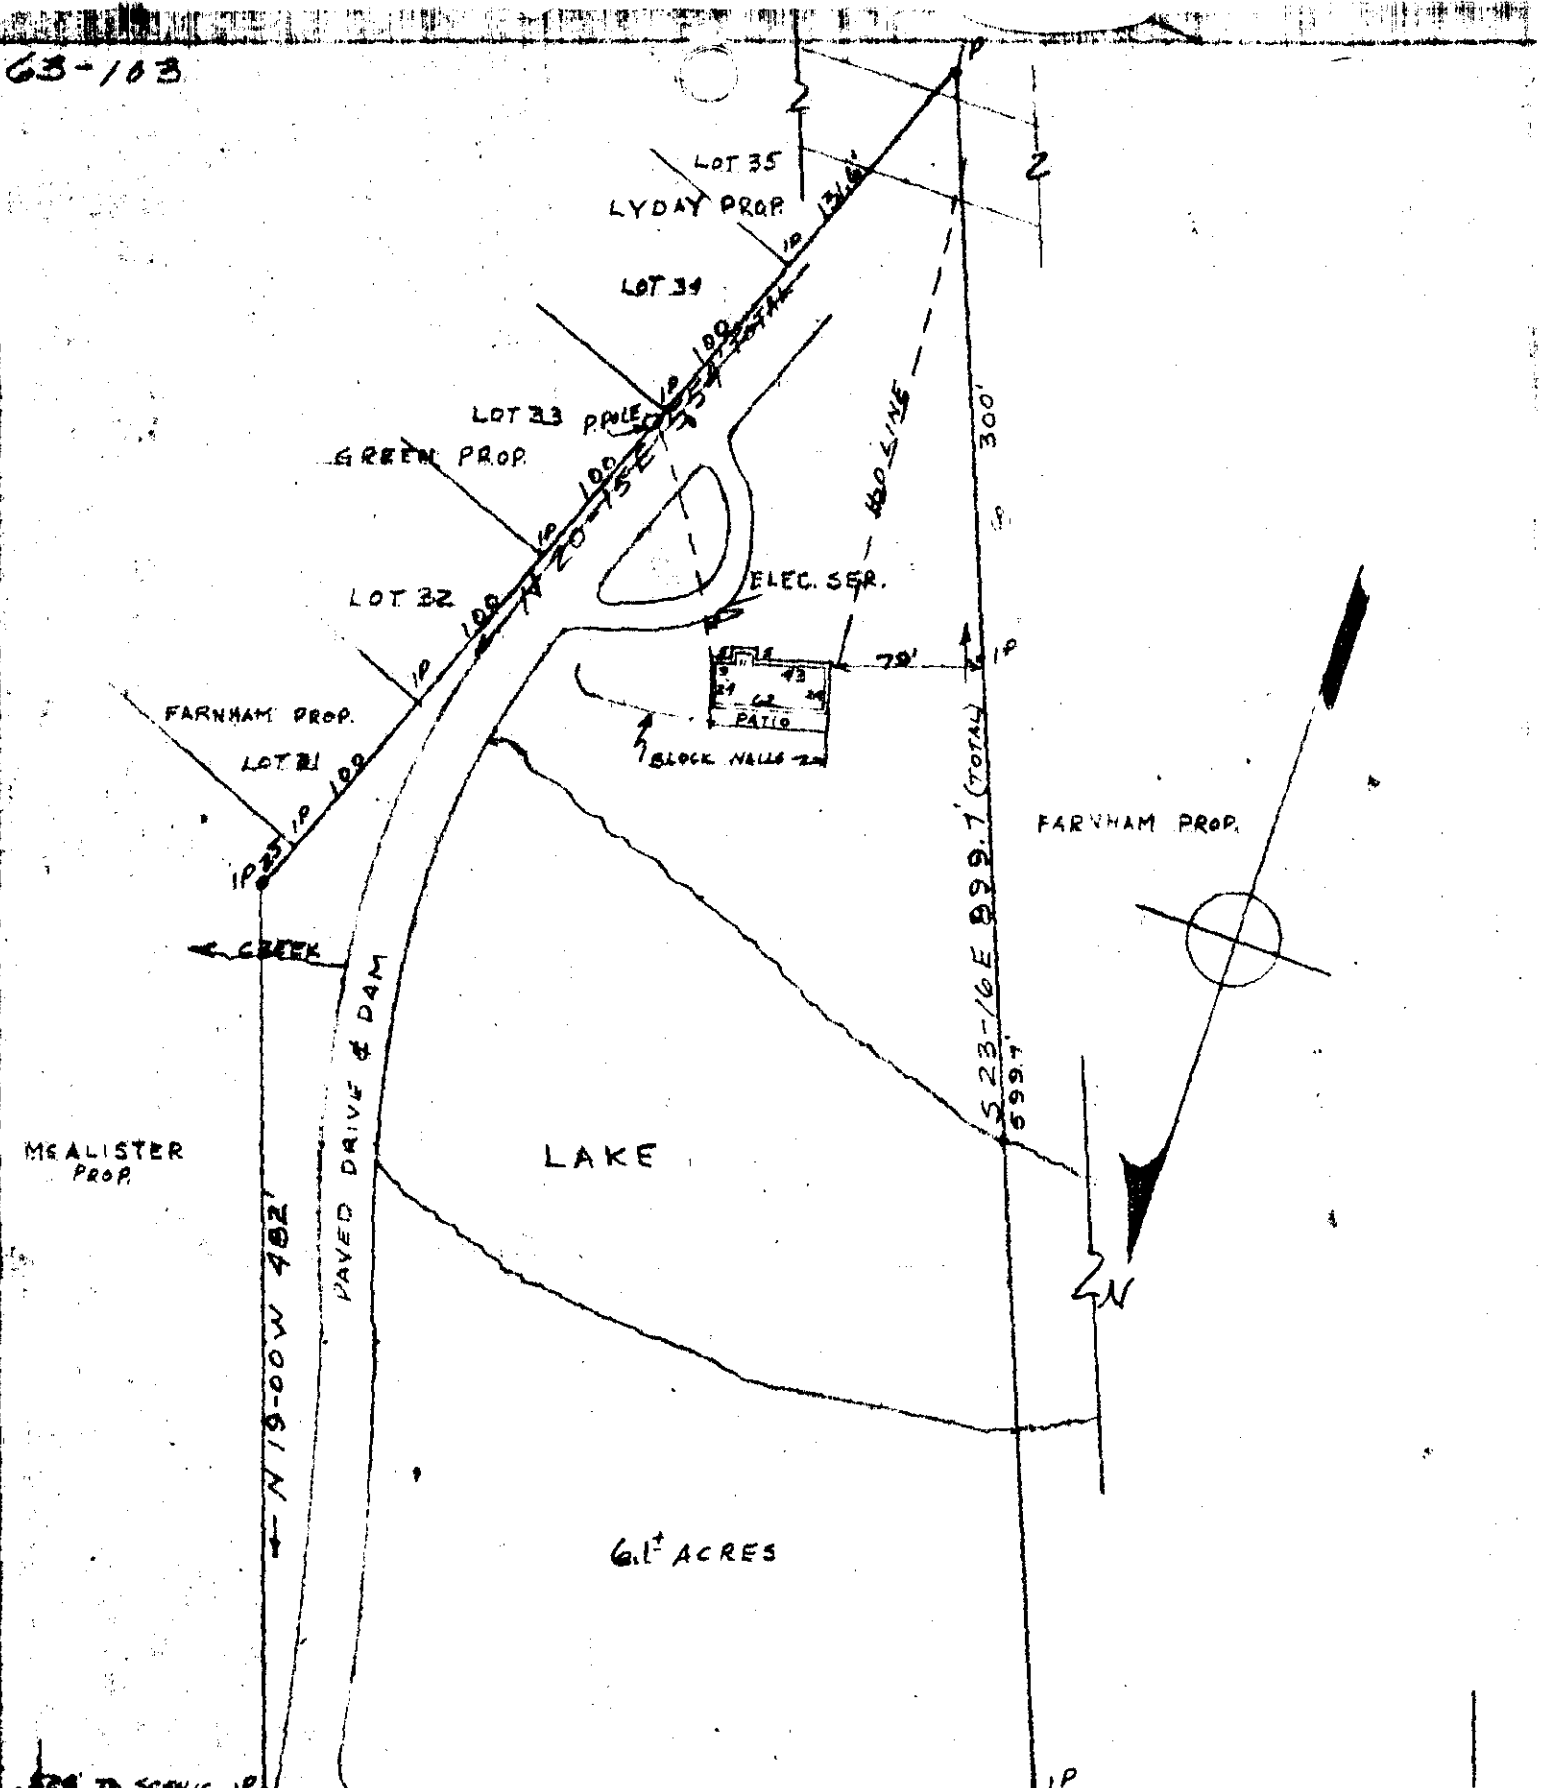

LITTLE TEXAS ROAD (HWY. 253)

PROPERTY OF
 WILLIAM D. AND SALLY D. HENSLEY
 LITTLE TEXAS ROAD (HWY. #253)
 NEAR TRAVELERS REST, S.C.
 SCALE: 1" = 100' NOV. 8, 1963

This is to certify that on the 8th day of November, 1963, I surveyed the property shown on this plat; being the same property as recorded in Deed Book 575 Page 475 recorded in R.M.C. Office, Greenville County, S.C.; and that the property lines, walls and buildings are as shown hereon; that the buildings located on said lot do not encroach or project on adjacent streets or property; and that no adjacent buildings or walls encroach or project on said premises; and that no utility lines cross the property except as shown hereon.

DEC 4 1963

William A. Howard

16185

RESC 490

GALWAY AND TERRELL

.500

EE8-141